

PIKE
H24
3-68 CODED

MISSISSIPPI
BOARD OF WATER COMMISSIONERS
416 North State Street
Jackson, Mississippi 39201

WATER WELL DRILLERS LOG

March 19 68 *Reverwell Drilling Co* *Pike*
date well completed firm name county well located

LANDOWNER: *Floyd Papercraft - Rt-1, Magnolia -*
(mailing address)

description of formations encountered	from	to
<i>Red Sandy clay</i>	<i>0</i>	<i>19</i>
<i>Red Sand</i>	<i>19</i>	<i>50</i>
<i>Red clay sand</i>	<i>50</i>	<i>85</i>
<i>Small gravel</i>	<i>85</i>	<i>90</i>
<i>chalky sand</i>	<i>90</i>	<i>110</i>
<i>Small gravel</i>	<i>110</i>	<i>121</i>


WELL LOCATION:
sec. *10* T. *2* N. R. *8* E
miles of (distance) (direction) (nearest town)

WELL PURPOSE: *drain*
(home, irrigation, municipal, industrial)

WELL COMPLETION DATA:
(1) diameter (inches) *4"*
(2) total depth (feet) *121*
(3) static water level (feet) *85* below top of ground.
(4) casing *Plastic bottom* (material) (depth)
if telescope see back.
(5) screen *6'* (length) *115'* (depth to top) *Plastic* (material)
(6) pump *None installed* (type power)

(7) electric log *no* (yes or no)
(organization running log)


(8) how well bottom plugged *wooden plug*
DRILLERS REMARKS: *New house*

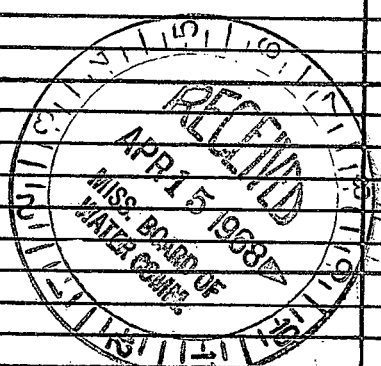

CODED

If well telescopes please sketch and show depths.

GROUND LEVEL

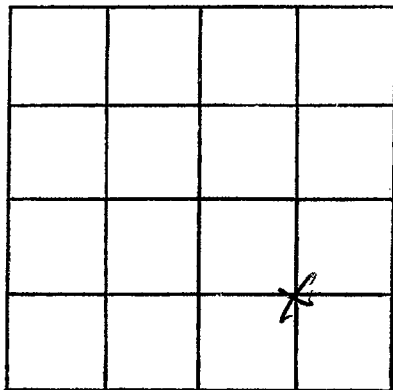

SECTION 10

Please indicate well location X.

ADDITIONAL INFORMATION

If more than one screen, show locations of each on sketch.