

PIKE
H25
3-68

CODED

MISSISSIPPI
BOARD OF WATER COMMISSIONERS
416 North State Street
Jackson, Mississippi 39201

WATER WELL DRILLERS LOG

March 68 *Renewell Humphreys Pike*
date well completed firm name county well located

LANDOWNER: *Miss Ahyné Winans RFD 1, Magnolia*
(mailing address)

description of formations encountered	from	to
Red clay	0	18
Red sandy clay	18	63
Gravel and sand mixed with clay	63	105
small brown gravel	105	120
Sandy, chalky sand	120	130
Sand and small gravel	130	140

WELL LOCATION:
sec. 12 T. 2 N. R. 8 E.
5 1/2 miles E of Magnolia
(distance) (direction) (nearest town)

WELL PURPOSE: *domestic*
(home, irrigation, municipal, industrial)

- WELL COMPLETION DATA:
- (1) diameter (inches) 4"
 - (2) total depth (feet) 140
 - (3) static water level (feet) 108 below top of ground.
 - (4) casing Plastic bottom
(material) (depth)

- (5) screen 6' 134'
(length) (depth to top)
4" Plastic
(size) (material)
- (6) pump 3/4 Sub 15
(HP) (yield gpm)
Elect
(type power)

- (7) electric log no
(yes or no)
(organization running log)


(8) how well bottom plugged wooden plug
DRILLERS REMARKS: red well hole

CODED



If well telescopes please sketch and show depths.

GROUND LEVEL

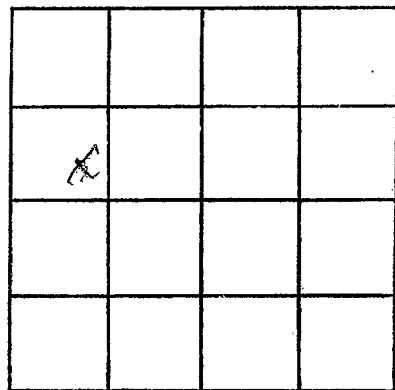

SECTION 12

Please indicate well location X.

ADDITIONAL INFORMATION

If more than one screen, show locations of each on sketch.