

PIKE
H28
6-68

MISSISSIPPI
BOARD OF WATER COMMISSIONERS
416 North State Street
Jackson, Mississippi 39201

WATER WELL DRILLERS LOG

6-3-68 date well completed, 1968 firm name, 68-Eggers Water Well Pike county well located

LANDOWNER: J. D. Jones, Magnolia RT Miss

description of formations encountered	from	to
Red Clay - Top Soil	0	15
Red Sand	15	40
Sand & Gravel	40	82
Gravel	82	110
Soupy Sand	110	152
Gravel & Sand	152	158
Chalk	158	

(mailing address)

WELL LOCATION:
sec. 1 T. 3 N. R. 8 E
9 miles SE of McComb

WELL PURPOSE: home
(home, irrigation, municipal, industrial)

- WELL COMPLETION DATA:
- (1) diameter (inches) 4
 - (2) total depth (feet) 158
 - (3) static water level (feet) 115 below top of ground.
 - (4) casing plastic 152 (material) (depth)
 - (5) screen 4 (size) 6' (length) 152 (depth to top) Sch 40 (material)
 - (6) pump 1 (HP) 5 (yield gpm) Elec (type power)
 - (7) electric log No (yes or no)
 - (8) how well bottom plugged


CODE

MISSISSIPPI BOARD OF WATER COMMISSIONERS

DRILLERS REMARKS:

If well telescopes please sketch and show depths.

GROUND LEVEL

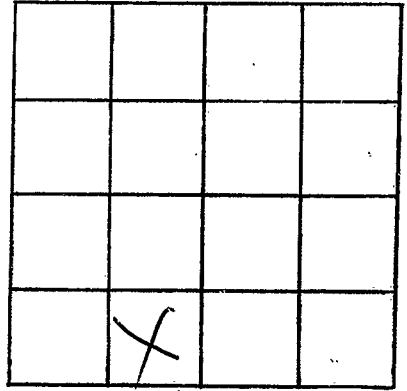

SECTION f

Please indicate well location X.

ADDITIONAL INFORMATION

If more than one screen, show locations of each on sketch.