

**MISSISSIPPI  
BOARD OF WATER COMMISSIONERS**  
416 North State Street  
Jackson, Mississippi 39201

**WATER WELL DRILLERS LOG**

**PIKE**  
H 29  
7-68

7-26-19 68 Fitzgerald Water Well Pike  
date well completed firm name county well located

LANDOWNER: Thad Cook  
Magnolia Rt Miss  
(mailing address)


WELL LOCATION:  
sec. 31 T. 2 N. R. 8 E.  
4 miles 50 of Magnolia  
(distance) (direction) (nearest town)

WELL PURPOSE: home  
(home, irrigation, municipal, industrial)

- WELL COMPLETION DATA:
- (1) diameter (inches) 4
  - (2) total depth (feet) 106
  - (3) static water level (feet) 55 below above top of ground.
  - (4) casing plastic 100  
(material) (depth)  
4 If telescope see back.  
(size)
  - (5) screen 6' 100  
(length) (depth to top)  
4 Sch 40  
(size) (material)
  - (6) pump \_\_\_\_\_ (HP) \_\_\_\_\_ (yield gpm)  
(type power)
  - (7) electric log NO  
(yes or no)  
(organization running log)
  - (8) how well bottom plugged Wood Peg

description of formations encountered	from	to
Red Clay	0	8
Red gravel	8	24
sand	21	50
sand gravel	50	62
Red Chalk	62	84
gravel & sand	84	106


**COBEN**

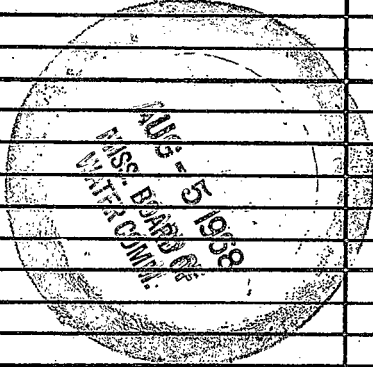

DRILLERS REMARKS:

If well telescopes please sketch and show depths.

GROUND LEVEL

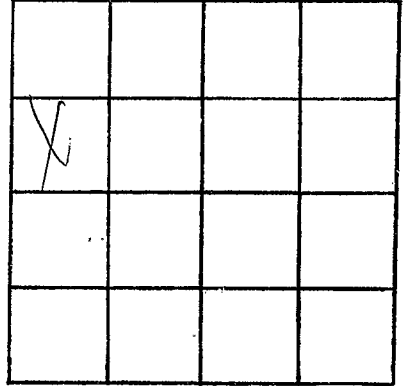

SECTION 31

Please indicate well location X.

ADDITIONAL INFORMATION

If more than one screen,  
show locations of each on sketch.