

PIKE
H30
8-64

MISSISSIPPI
BOARD OF WATER COMMISSIONERS
416 North State Street
Jackson, Mississippi 39201

WATER WELL DRILLERS LOG

8-2-1968 date well completed
B Longwell Water Well firm name
Pike county well located

LANDOWNER: Otto Marshall

description of formations encountered	from	to
top soil & clay	0	25
sand	25	25
gravel & sand	25	100

Magnolia Rd MISS
(mailing address)


WELL LOCATION:
sec 23 T 2 N R 8 E
S W
8 miles E of Magnolia
(distance) (direction) (nearest town)

WELL PURPOSE: home
(home, irrigation, municipal, industrial)

WELL COMPLETION DATA:

- (1) diameter (inches) 4
- (2) total depth (feet) 100
- (3) static water level (feet) 80 below top of ground
- (4) casing plastic 94 (material) (depth)
if telescope see back.
(size)
- (5) screen 61 94 (length) (depth to top)
plastic screen (material)
(size)
- (6) pump 1-1/2 HP 8 (HP) (yield gpm)
Elex (type power)
- (7) electric log (yes or no)

CODED

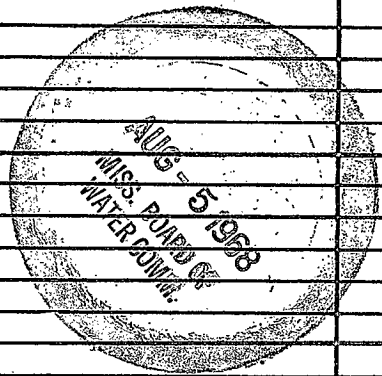


(organization running log)

(8) how well bottom plugged

DRILLERS REMARKS:

If well telescopes please sketch and show depths.

GROUND LEVEL

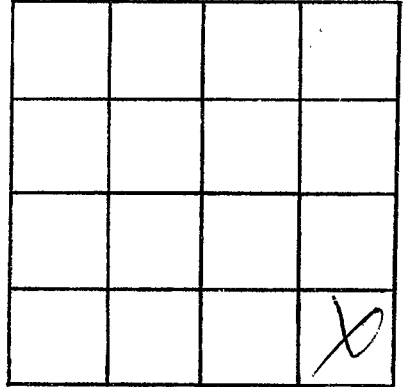

SECTION 29

Please indicate well location X.

ADDITIONAL INFORMATION

If more than one screen, show locations of each on sketch.