

**MISSISSIPPI  
BOARD OF WATER COMMISSIONERS**  
416 North State Street  
Jackson, Mississippi 39201

**WATER WELL DRILLERS LOG**

PIKE  
H 31  
8-68

**CODED**

8-2- 19 68 Fitzgerald Water Well PIKE  
date well completed firm name county well located

LANDOWNER: W.D. Nelson  
Rt Magnolia Miss  
(mailing address)


description of formations encountered	from	to
<u>top soil &amp; clay</u>	<u>0</u>	<u>30</u>
<u>Red sand</u>	<u>30</u>	<u>95</u>
<u>Gravel &amp; Sand</u>	<u>75</u>	<u>100</u>

WELL LOCATION:  
sec 26 T 2 N R 8 E  
8 miles E of Magnolia  
(distance) (direction) (nearest town)

WELL PURPOSE: home  
(home, irrigation, municipal, industrial)

- WELL COMPLETION DATA:
- (1) diameter (inches) 4
  - (2) total depth (feet) 100
  - (3) static water level (feet) 70 below top of ground
  - (4) casing cast 94  
(material) (depth)
  - 4 if telescope see back.  
(size)
  - (5) screen 6' 94  
(length) (depth to top)
  - 4 sch 40  
(size) (material)
  - (6) pump 4 12  
(HP) (yield gpm)
  - Elec  
(type power)
  - (7) electric log NO  
(yes or no)
  - (organization/running log)
  - (8) how well bottom plugged wood peg


**CODED**

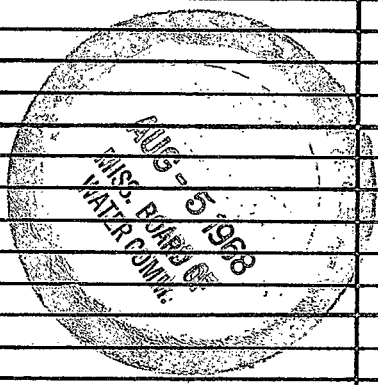

DRILLERS REMARKS:

If well telescopes please sketch and show depths.

GROUND LEVEL

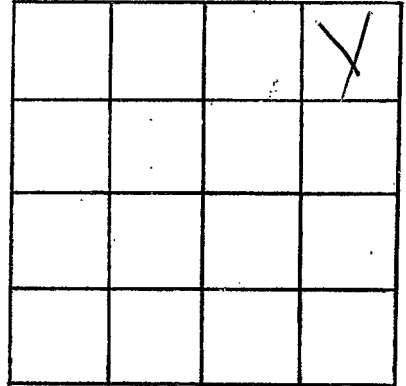

SECTION 76

Please indicate well location X.

ADDITIONAL INFORMATION

If more than one screen, show locations of each on sketch.