

H 33
2-22-63

WATER WELL DRILLERS LOG

CODED


Date: 2-22, 1963, Driller: Chester Reeves County: Pike
(Name)

- (1) Owner of Land: M.D. Durham (Name)
RFD 1, Magnolia (Address)
- (2) Location: 1/4, 1/4, Sec. 10 T 2 R 8
4 miles N.E. of Magnolia
(distance) (direction) (Nearest Town)
- (3) Topography: Hilly
(Hilly) (Flat) (Level)
- (4) Purpose of Well: Domestic
(Domestic Irrigation
Municipal, Industrial, Other)

Description & Color of Materials Sand, Clay, Red Clay, Shell, etc.	Thick- ness Feet	De Fe
Red Clay	25	25
Laterally sand	20	25
Sand with log	14	14
Gravel		

Information upon completion of well:

- (1) Diameter 4 inches.
- (2) Total Depth 119 feet.
- (3) Water Level 80 feet below top of ground.
- (4) Cased to Bottom Size 4'
- (5) Screen: Size 4", Length 4'
- (6) Were any formations sealed against pollution?
yes, no.

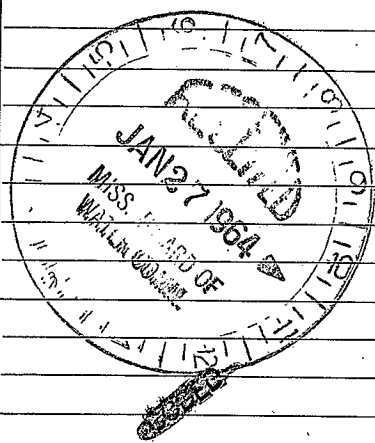

Cannot locate
RM

If YES depth of formation _____

Why _____

Drillers Remarks: good well
Bad

REEVES WELL & PUMP CO.
P. O. BOX 71 - PHONE 684-1451

Well No.

(Use Back Side)

[The page contains extremely faint, illegible text, likely bleed-through from the reverse side of the document. The text is scattered across the page and cannot be transcribed.]