

CODED

CODED

Pipe CODED
 H 34
 9-14-68

MISSISSIPPI
 BOARD OF WATER COMMISSIONERS
 416 North State Street
 Jackson, Mississippi 39201

WATER WELL DRILLERS LOG

9-14 1968 Felgiant well Pike
 date well completed firm name county well located

LANDOWNER:
Jerry Bush
RR. Magnolia, Miss.
 (mailing address)

description of formations encountered	from	to
<u>Red clay</u>	0	25
<u>Red sand</u>	25	60
<u>Coarse gravel</u>	60	90
<u>Red sand</u>	90	180
<u>Coarse sand</u>	110	120

WELL LOCATION:
 sec. 22 T. 3 N R. 8 E
 S W
4 miles E of Magnolia
 (distance) (direction) (nearest town)


WELL PURPOSE: home
 (home, irrigation, municipal, industrial)

- WELL COMPLETION DATA:
- (1) diameter (inches) 4
 - (2) total depth (feet) 120
 - (3) static water level (feet) 70 below above top of ground.
 - (4) casing Plastic, 114,
 (material) (depth)
4 if telescope see back.
 (size)
 - (5) screen 6, 114
 (length) (depth to top)
4, Plastic
 (size) (material)
 - (6) pump 7, 3
 (HP) (yield gpm)
Electric
 (type power)
 - (7) electric log Yes
 (yes or no)

 (organization running log)


(8) how well bottom plugged 2 inch plug

DRILLERS REMARKS: _____

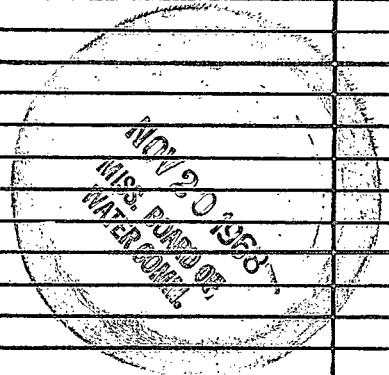

If well telescopes please sketch and show depths.

GROUND LEVEL

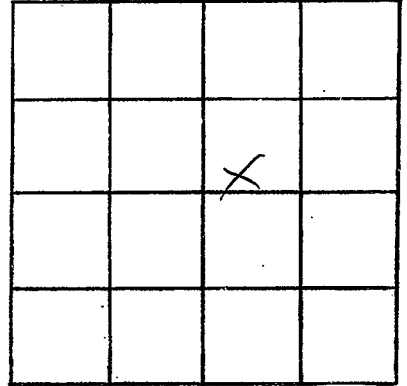

SECTION 22

Please indicate well location X.

ADDITIONAL INFORMATION

If more than one screen, show locations of each on sketch.