

CODED

PIKE
H 35
9-25-68

MISSISSIPPI
BOARD OF WATER COMMISSIONERS
416 North State Street
Jackson, Mississippi 39201

WATER WELL DRILLERS LOG

Sept 25 68 Lewis well pumps L&L
date well completed firm name county well located

LANDOWNER: Mrs. E. Lawrencecraft
RT 1, Magnolia
(mailing address)

description of formations encountered	from	to
<u>Red clay</u>	<u>0</u>	<u>33</u>
<u>Red sand</u>	<u>33</u>	<u>65</u>
<u>Sandy clay</u>	<u>65</u>	<u>100</u>
<u>Small gravel sand</u>	<u>100</u>	<u>117</u>

WELL LOCATION:
sec. 10 T. 2 N. R. 8 E.
4 miles East of Magnolia
(distance) (direction) (nearest town)

WELL PURPOSE: Home
(home, irrigation, municipal, industrial)

WELL COMPLETION DATA:

(1) diameter (inches) 4"

(2) total depth (feet) 117

(3) static water level (feet) 84 below top of ground.

(4) casing Plastic ballast
(material) (depth)

_____ if telescope see back.
(size)

(5) screen 6' 117
(length) (depth to top)

4" Plastic
(size) (material)

(6) pump 3/4 hp 8
(HP) (yield gpm)

Elect
(type power)

(7) electric log NO
(yes or no)

_____ (organization running log)

(8) how well bottom dugged wooden plug


DRILLERS REMARKS:
New house.

NOV 2 - 1968

MISSISSIPPI
BOARD OF WATER COMMISSIONERS
JACKSON, MISSISSIPPI

If well telescopes please sketch and show depths.

GROUND LEVEL

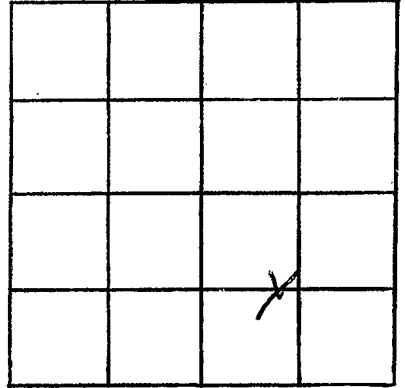

SECTION 10

Please indicate well location X.

ADDITIONAL INFORMATION

If more than one screen,
show locations of each on sketch.