

CODED

PIKE  
H36  
9-9-68

CODED

MISSISSIPPI  
BOARD OF WATER COMMISSIONERS  
416 North State Street  
Jackson, Mississippi 39201


WATER WELL DRILLERS LOG

Sept 9 1968 J. T. Covington Pike  
date well completed firm name county well located

LANDOWNER: <u>Alva Stanford</u>	description of formations encountered	from	to
<u>Magnolia, Miss.</u> (mailing address)	<del>0-45</del> <u>clay</u>	0	45
WELL LOCATION: sec. <u>1</u> T <u>2</u> N - R <u>8</u> E <u>12</u> miles <u>East</u> of <u>Magnolia</u> (distance) (direction) (nearest town)	<u>Sand</u>	45	98
WELL PURPOSE: <u>Home</u> (home, irrigation, municipal, industrial)	<u>clay</u>	98	110
WELL COMPLETION DATA: (1) diameter (inches) <u>4"</u> (2) total depth (feet) <u>169'</u> (3) static water level (feet) <u>105'</u> below above top of ground. (4) casing <u>Plastic</u> , <u>163'</u> (material) (depth) <u>4"</u> if telescope see back. (size) (5) screen <u>6'</u> , <u>163'</u> (length) (depth to top) <u>4"</u> , <u>Plastic</u> (size) (material) (6) pump <u>1/2</u> , <u>7</u> (HP) (yield gpm) <u>A.C.</u> (type power) (7) electric log _____ (yes or no) (organization running log) (8) how well bottom plugged <u>wood</u>	<u>Sand &amp; Rocks</u>	110	169
DRILLERS REMARKS:			

If well telescopes please sketch and show depths.

GROUND LEVEL

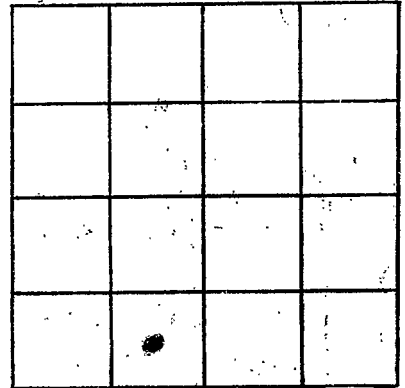

SECTION 1

Please indicate well location X.

ADDITIONAL INFORMATION

If more than one screen,  
show locations of each on sketch.