

CODED

CODED

Pike  
H 37  
8-68

MISSISSIPPI  
BOARD OF WATER COMMISSIONERS  
416 North State Street  
Jackson, Mississippi 39201

WATER WELL DRILLERS LOG

Aug 27 1968 Lewis Well Drilling Co. Pike  
date well completed firm name county well located

LANDOWNER: James L. Smith  
RFD  
Mapahala -  
(mailing address)

| description of formations encountered | from | to  |
|---------------------------------------|------|-----|
| Red clay                              | 0    | 18  |
| Red Sand & Sand                       | 18   | 55  |
| Red Sand & Sand                       |      |     |
| Sea gravel                            | 55   | 92  |
| Sea gravel & Sand                     | 92   | 101 |
| Red chalk                             | 101  | 103 |
| Sea gravel & Sand                     | 103  | 112 |

WELL LOCATION:  
sec. 9 T. 2 N. R. 8 E.  
3 1/2 miles S of Mapahala  
(distance) (direction) (nearest town)

WELL PURPOSE:  
(home, irrigation, municipal, industrial)


WELL COMPLETION DATA:

- (1) diameter (inches) 4"
- (2) total depth (feet) 112
- (3) static water level (feet) 96 below above top of ground.
- (4) casing Plastic Ballast (material) (depth)
- (size) if telescope see back.
- (5) screen 6' 106 (length) (depth to top)
- 4" (size) Plastic (material)
- (6) pump 1/2 Sub 12 (HP) (yield gpm)
- (type power)
- (7) electric log NO (yes or no)

(organization running log)


(8) how well bottom plugged  
wooden plug

DRILLERS REMARKS:  
New house.

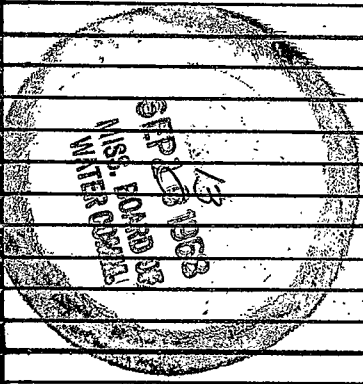

If well telescopes please sketch and show depths.

GROUND LEVEL

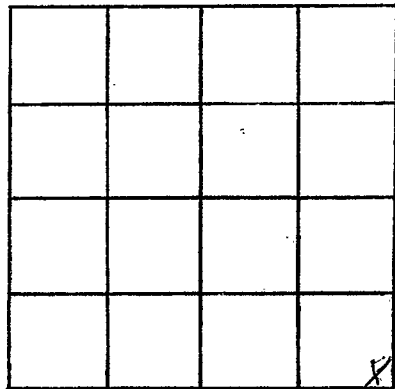

SECTION 9

Please indicate well location X.

ADDITIONAL INFORMATION

If more than one screen, show locations of each on sketch.