

CODED

CODED

Pike

H38

8-68

MISSISSIPPI
 BOARD OF WATER COMMISSIONERS
 416 North State Street
 Jackson, Mississippi 39201

WATER WELL DRILLERS LOG

August 28 1968
date well completed

68 Reeves Well Drilling Co.
firm name

Pike
county well located

LANDOWNER: George Spear

description of formations encountered

from to

RFD

Maplewood, Miss
(mailing address)

clay & gravel
bed small gravel

WELL LOCATION:

sec. 23 T. 2 N. R. 8 E.
6 miles SE of Maplewood
(distance) (direction) (nearest town)

small sand
1.5 84

WELL PURPOSE: farm
(home, irrigation, municipal, industrial)

WELL COMPLETION DATA:

(1) diameter (inches) 4"

(2) total depth (feet) 84

(3) static water level (feet) 3.5 below top of ground.

(4) casing plastic ballast
(material) (depth)

(size) if telescope see back.

(5) screen 6' 78'
(length) (depth to top)

4" plastic
(size) (material)

(6) pump 1/2 sub 12
(HP) (yield gpm)


elect
(type power)

(7) electric log No
(yes or no)

(organization running log)


(8) how well bottom plugged wooden plug

DRILLERS REMARKS: new location

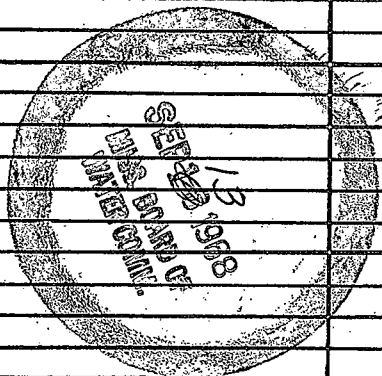

If well telescopes please sketch and show depths.

GROUND LEVEL

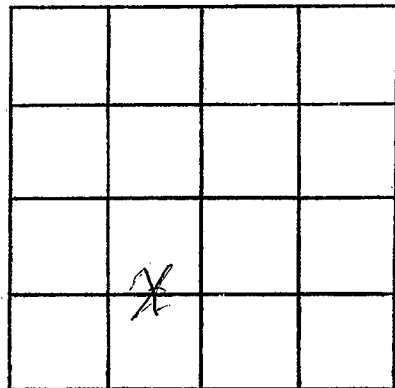

SECTION 23

Please indicate well location X.

ADDITIONAL INFORMATION

If more than one screen,
show locations of each on sketch.