

**MISSISSIPPI
BOARD OF WATER COMMISSIONERS**
416 North State Street
Jackson, Mississippi 39201

CODED

WATER WELL DRILLERS LOG

Pike
H 391
11-1-68

Name Novel date well completed 1968 firm name J.T. Conington county well located Pike

LANDOWNER: Nolan Taylor
Morgan, Miss
(mailing address)

description of formations encountered	from	to
<u>Clay Sand</u>	<u>0</u>	<u>45</u>
<u>Sand & Rocks</u>	<u>45</u>	<u>129</u>
		<u>45</u>
		<u>84</u>

WELL LOCATION:
sec 28 T 2 N R 8 E
S W
5 miles East of Morgan
(distance) (direction) (nearest town)

WELL PURPOSE: Home
(home, irrigation, municipal, industrial)

WELL COMPLETION DATA:

(1) diameter (inches) 4"

(2) total depth (feet) 129'

(3) static water level (feet) 85' below above top of ground.

(4) casing Plastic, 123',
(material) (depth)
(size) If telescope see back.

(5) screen 6', 129'
(length) (depth to top)
4", Plastic
(size) (material)

(6) pump 7, 7
(HP) (yield gpm)
A.C.
(type power)

(7) electric log _____
(yes or no)
(organization running log)

(8) how well bottom plugged wood


CODED

DRILLERS REMARKS:

DEC 23 1968
MISS. BD. OF WATER COMMISSIONERS

If well telescopes please sketch and show depths.

GROUND LEVEL

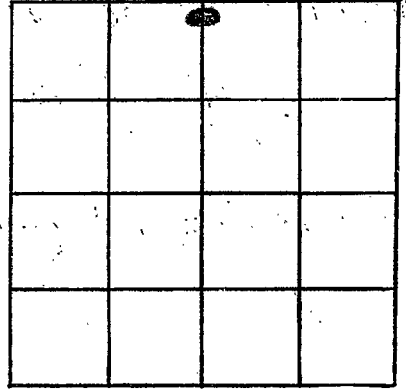

SECTION 29

Please indicate well location X.

ADDITIONAL INFORMATION

If more than one screen,
show locations of each on sketch.