

CODED

MISSISSIPPI
BOARD OF WATER COMMISSIONERS
416 North State Street
Jackson, Mississippi 39201

CODED

WATER WELL DRILLERS LOG

<i>Pike</i>
H 40
11-13-68

11-13 date well completed *W Fitzgerald Water Well* firm name *Pike* county well located

LANDOWNER: *Robert Graves*

description of formations encountered

from to

St. Magnolia Miss

Top Soil + clay 0 18
sand 18 25
gravel 25 35
sand 35 45
Water Sand + gravel 45 122

(mailing address)

WELL LOCATION:

sec. 10 T. 2 N. R. 8 E. S. 5 W
 (distance) (direction) (nearest town)
5 miles *E* of *Magnolia*

WELL PURPOSE: *home*
(home, irrigation, municipal, industrial)

WELL COMPLETION DATA:

- (1) diameter (inches) 4
- (2) total depth (feet) 120
- (3) static water level (feet) 90 below top of ground.
- (4) casing *plastic, 1 1/4"* (material) (depth)
4 (size) if telescope see back.
- (5) screen 6' (length) 1 1/4" (depth to top)
4 (size) *plastic* (material)
- (6) pump 1/2 hp sub (HP) 12 (yield gpm)
elec (type power)
- (7) electric log no (yes or no)

CODED

(organization running log)

(8) how well bottom plugged *Wvd poq*


DRILLERS REMARKS:

DEC 1 1968

MISS. BO. OF WATER COM.

If well telescopes please sketch and show depths.

GROUND LEVEL

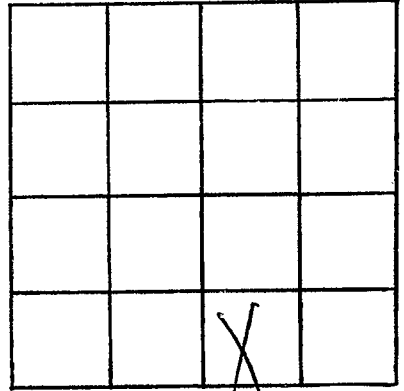

SECTION 10

Please indicate well location X.

ADDITIONAL INFORMATION

If more than one screen, show locations of each on sketch.