

CODED

Pike  
H41  
1-22-69

MISSISSIPPI  
BOARD OF WATER COMMISSIONERS  
416 North State Street  
Jackson, Mississippi 39201

CODED

WATER WELL DRILLERS LOG

Jan 22 1969 H. L. VARNADO & SON, INC. PIKE  
date well completed firm name county well located

LANDOWNER:

ZEB JACKSON  
Rt 4 Box 209 Magnolia, Miss  
(mailing address)

description of formations encountered

from to

RED SANDY CLAY 0' 30'  
SAME 30' 40'  
CLAY GRAVEL & SAND 50' 60'  
BIG GRAVEL & SAND 60' 90'  
CLAY GRAVEL & SAND 90' 110'  
SAME 110' 120'  
WATER SAND 120' 136'

WELL LOCATION:

sec 29 T 2 N R 8 E  
5 miles SE of Magnolia  
(distance) (direction) (nearest town)

WELL PURPOSE:

Home  
(home, irrigation, municipal, industrial)

WELL COMPLETION DATA:

- (1) diameter (inches) 2" Plastic
- (2) total depth (feet) 136'
- (3) static water level (feet) 70' below top of ground.
- (4) casing Plastic (material) (depth)
- 2" (size) if telescope see back.
- (5) screen 7" 129' (length) (depth to top)
- 2" Plastic (size) (material)
- (6) pump 1 1/2 230 (HP) (yield gph)
- Elect. 220V. (type power)
- (7) electric log NO (yes or no)

CODED

JAN 31 1969

MISS. BD. OF  
WATER COMMISSIONERS

(organization running log)

(8) how well bottom plugged Brass  
Backwash Valve

DRILLERS REMARKS:


If well telescopes please sketch and show depths.

136' Total Depth

GROUND LEVEL

139' - 3" Plastic Pipe

7' x 9" Plastic Screen

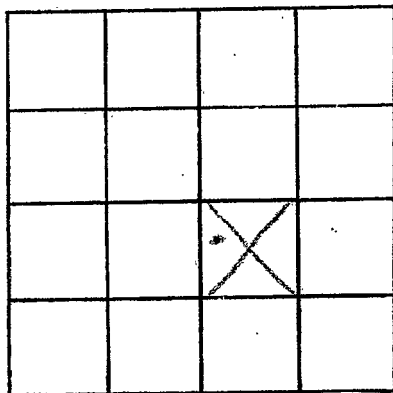

SECTION 29

Please indicate well location X.

ADDITIONAL INFORMATION

If more than one screen, show locations of each on sketch.