

Pike
H 43
1-20-69

MISSISSIPPI
 BOARD OF WATER COMMISSIONERS
 416 North State Street
 Jackson, Mississippi 39201

CODED

WATER WELL DRILLERS LOG

Jan. 20 1969 J. T. Thompson Pike
 date well completed firm name county well located

LANDOWNER: Jimmy Steel
Memphis, Miss.
 (mailing address)

description of formations encountered	from	to
<u>Clay</u>	<u>0</u>	<u>30</u>
<u>Sand & Shells</u>	<u>30</u>	<u>70</u>
<u>Sand</u>	<u>70</u>	<u>118</u>

WELL LOCATION:
 sec. 21 T. 2 N. R. 2 E.
5 E S W
5 miles East of Memphis
 (distance) (direction) (nearest town)

WELL PURPOSE: Home
 (home, irrigation, municipal, industrial)

- WELL COMPLETION DATA:
- (1) diameter (inches) 4"
 - (2) total depth (feet) 100'
 - (3) static water level (feet) 50' below above top of ground.
 - (4) casing Plastic, 70'
 (material) (depth)
 - (size) if telescope see back.
 - (5) screen 6', 90'
 (length) (depth to top)
 - 4", Plastic
 (size) (material)
 - (6) pump 1/2, 5
 (HP) (yield gpm)
 - A.C.
 (type power)
 - (7) electric log _____
 (yes or no)
 - _____
 (organization running log)
 - (8) how well bottom plugged wood

CODED


JAN 28 1969

MISS. Bd. of WATER COMM.

DRILLERS REMARKS:

If well telescopes please sketch and show depths.

GROUND LEVEL

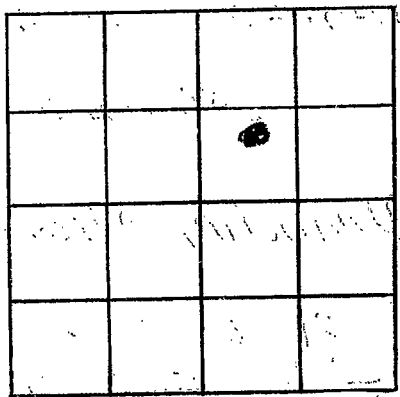

SECTION 21

Please indicate well location X.

ADDITIONAL INFORMATION

If more than one screen, show locations of each on sketch.