

CODED

MISSISSIPPI BOARD OF WATER COMMISSIONERS  
416 North State Street  
Jackson, Mississippi 39201

CODED

WATER WELL DRILLERS LOG

Pike  
H44  
1-23-69

JAN. 23 1969 date well completed  
S.T. Edgington firm name  
Pike county well located

LANDOWNER: William Stealing

description of formations encountered	from	to
Clay	0	30
Sand & chalk	30	90
Sand	90	138

Maple Hill, Miss.  
(mailing address)

WELL LOCATION:

sec 20 T2N R3E  
4 NE S W  
4 miles East of Osprey  
(distance) (direction) (nearest town)

WELL PURPOSE: Home  
(home, irrigation, municipal, industrial)

WELL COMPLETION DATA:

- (1) diameter (inches) 4"
- (2) total depth (feet) 138'
- (3) static water level (feet) 90' below top of ground.
- (4) casing Plastic 12" (material) (depth)  
(size) If telescope see back.
- (5) screen 6" 138' (length) (depth to top)  
4" Plastic (size) (material)
- (6) pump 1/2 (HP) 6 (yield gpm)  
A.C. (type power)
- (7) electric log (yes or no)  
(organization running log)
- (8) how well bottom plugged wood

CODED

CODED


DRILLERS REMARKS:

JAN 28 1969

MISS. BD. OF WATER COMM.

If well telescopes please sketch and show depths.

GROUND LEVEL

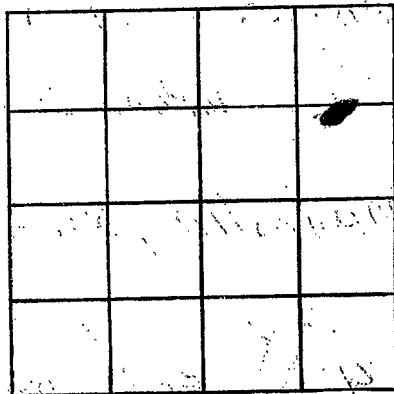

SECTION 70

Please indicate well location X.

ADDITIONAL INFORMATION

If more than one screen, show locations of each on sketch.