

CODED
 Pike
 H45
 1-69

MISSISSIPPI
 BOARD OF WATER COMMISSIONERS
 416 North State Street
 Jackson, Mississippi 39201

CODED

WATER WELL DRILLERS LOG

1- 1969 Fitzgerald Water Well Pike
 date well completed firm name county well located

LANDOWNER: James Huchabee
Magnolia Rd MISS
 (mailing address)

description of formations encountered	from	to
<u>Red clay</u>	<u>0</u>	<u>20</u>
<u>Red sand</u>	<u>20</u>	<u>70</u>
<u>Coarse sand & gravel</u>	<u>70</u>	<u>96</u>

WELL LOCATION:
 sec 22 T 2 N R 8 E
5 miles E of Magnolia
 (distance) (direction) (nearest town)

WELL PURPOSE: home
 (home, irrigation, municipal, industrial)

- WELL COMPLETION DATA:
- diameter (inches) 4
 - total depth (feet) 96
 - static water level (feet) 65 below top of ground.
 - casing plastic, 90,
 (material) (depth)
4 if telescope see back.
 (size)
 - screen 6, 90
 (length) (depth to top)
4, plastic
 (size) (material)
 - pump 3/4, 7
 (HP) (yield gpm)
Elu
 (type power)
 - electric log No
 (yes or no)
 (organization running log)
 - how well bottom plugged wood peg


CODED

DRILLERS REMARKS:

FEB 13 1969
 MISS. Bd. of
 WATER COM.

If well telescopes please sketch and show depths.

GROUND LEVEL

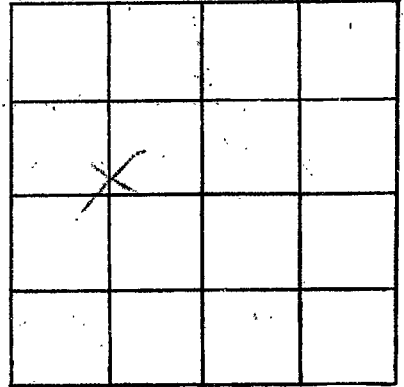

SECTION 22

Please indicate well location X.

ADDITIONAL INFORMATION

If more than one screen,
show locations of each on sketch.