

Pike
 H 47
 12-68

MISSISSIPPI
 BOARD OF WATER COMMISSIONERS
 416 North State Street
 Jackson, Mississippi 39201

WATER WELL DRILLERS LOG

Dec 10 1968 *Reverwell Pump Co - Pike* RECEIVED
 date well completed firm name county well located

LANDOWNER: *Milton*
Simmons
 Rt-1, *Mapolia*
 (mailing address)

description of formations encountered	from	to
<i>yellow clay</i>	<i>0</i>	<i>12</i>
<i>Red sand</i>	<i>12</i>	<i>26</i>
<i>Red Soupy sand</i>	<i>26</i>	<i>159</i>
<i>Sand with pea gravel</i>	<i>159</i>	<i>163</i>

WELL LOCATION:
 sec. *14* T. *2* N. R. *8* E.
5 miles *E* of *Mapolia*
 (distance) (direction) (nearest town)

WELL PURPOSE: *Home*
 (home, irrigation, municipal, industrial)

WELL COMPLETION DATA:
 (1) diameter (inches) *4"*
 (2) total depth (feet) *163*
 (3) static water level (feet) *88* below top of ground.
 (4) casing *Plastic Ballast*
 (material) (depth)
 (size) if telescope see back.
 (5) screen *6'* *157*
 (length) (depth to top)
4" *Plastic*
 (size) (material)
 (6) pump *3/4 hp* *12*
 (HP) (yield gpm)
Elect
 (type power)
 (7) electric log *No*
 (yes or no)
 (organization running log)

(8) how well bottom plugged
wooden plug
 DRILLERS REMARKS:
old well bad.


CODED

MAR 27 1969

MISS. ED. OF
 WATER BOARD

If well telescopes please sketch and show depths.

GROUND LEVEL

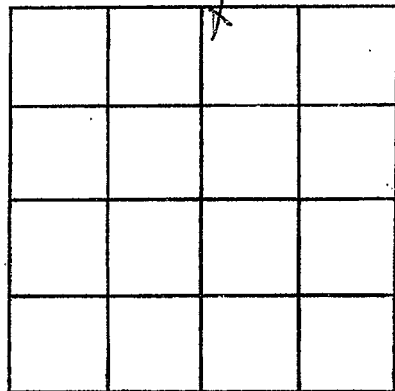

SECTION 14

Please indicate well location X.

ADDITIONAL INFORMATION

If more than one screen, show locations of each on sketch.