

CODED

CODED

MISSISSIPPI  
 BOARD OF WATER COMMISSIONERS  
 416 North State Street  
 Jackson, Mississippi 39201

WATER WELL DRILLERS LOG

Pike  
 H48  
 2-7-69

Feb 7 1969 *Keenwell Drilling* *Pike*  
 date well completed firm name county well located

LANDOWNER: *U. Y. Felder Jr.*  
*RFD 1*  
*Maple*  
 (mailing address)

description of formations encountered	from	to
<i>Red clay</i>	<i>0</i>	<i>17</i>
<i>Red sand &amp; chalk</i>	<i>17</i>	<i>95</i>
<i>Red gravel &amp; sand</i>	<i>95</i>	<i>100</i>

WELL LOCATION:  
 sec. *17* T *2* N R *8* E  
*2 1/2 - 3* miles *ESE* of *Maple*  
 (distance) (direction) (nearest town)

WELL PURPOSE: *Home*  
 (home, irrigation, municipal, industrial)

- WELL COMPLETION DATA:
- (1) diameter (inches) *4"*
  - (2) total depth (feet) *100 ft.*
  - (3) static water level (feet) *90'* below top of ground. *above*
  - (4) casing *Plastic bottom*  
 (material) (depth)  
 (size) if telescope see back.
  - (5) screen *6' 94'*  
 (length) (depth to top)  
*4"* *Plastic*  
 (size) (material)
  - (6) pump *old pump*  
 (HP) (yield gpm)  
*Steel*  
 (type power)
  - (7) electric log \_\_\_\_\_  
 (year no.)  
 (organization running log)

(8) how well bottom plugged *wooden plug*

DRILLERS REMARKS:  
*old well bore*


CODED

APR 24 1969

MISSISSIPPI BOARD OF WATER COMMISSIONERS

If well telescopes please sketch and show depths.

GROUND LEVEL

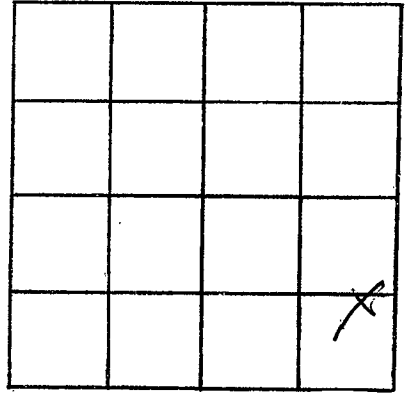

SECTION 17

Please indicate well location X.

ADDITIONAL INFORMATION

If more than one screen,  
show locations of each on sketch.