

Pike
H 50
4-16-69

MISSISSIPPI
BOARD OF WATER COMMISSIONERS
416 North State Street
Jackson, Mississippi 39201

WATER WELL DRILLERS LOG

No. April 19 69 J.T. Carington & Son Pike
date well completed firm name county well located

LANDOWNER:
Joe Forman
Magnolia, Miss.
(mailing address)

WELL LOCATION:
sec. 20 T. 2 N R. 9 E
4 miles S. East of Magnolia
(distance) (direction) (nearest town)

description of formations encountered	from	to
Clay	0	60
Red Clay	10	40
Clay sh.	40	75
Sand	75	105
Sand Bank	105	127

WELL PURPOSE:
(home, irrigation, municipal, industrial)

WELL COMPLETION DATA:

(1) diameter (inches) 4

(2) total depth (feet) 127

(3) static water level (feet) 15 below top of ground

(4) casing (material) Plastic, (depth) 127

4 (size) if telescope see back.

(5) screen 6 (length), 127 (depth to top)

4 (size), Plastic (material)

(6) pump 1/2 (HP), 900 (yield gpm)

Elec. (type power)

(7) electric log (yes or no)

(organization running log)

(8) how well bottom plugged wired


JUN 4 - 1969

MISS. BD. OF WATER COMMISSIONERS

DRILLERS REMARKS:

If well telescopes please sketch and show depths.

GROUND LEVEL

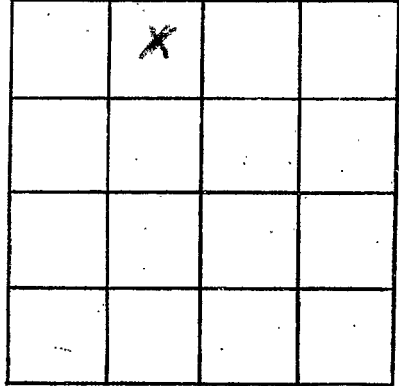

SECTION 20

Please indicate well location X.

ADDITIONAL INFORMATION

If more than one screen,
show locations of each on sketch.