

Pike Co
 H 52
 A-24-70

MISSISSIPPI
 BOARD OF WATER COMMISSIONERS
 416 North State Street
 Jackson, Mississippi 39201

WATER WELL DRILLERS LOG

April 24 1970 Chester Kernes Pike-
 date well completed firm name county well located

LANDOWNER: Woodman
 Summary
 PFD, Magnolia
 (mailing address)

description of formations encountered	from	to
	Red clay sand	0
Red chalk	8	26
Red sand	26	40
Red chalk sand	40	65
chalk	65	92
Red gravel sand	92	100
	100	108

WELL LOCATION:
 sec. 15 T. 2 R. 8 E 065
 3 1/2 miles ESE Magnolia
 (distance) (direction) (nearest town)

WELL PURPOSE: Home
 (home, irrigation, municipal, industrial)


- WELL COMPLETION DATA:
- (1) diameter (inches) 4"
 - (2) total depth (feet) 108
 - (3) static water level (feet) 67 below top of ground.
 - (4) casing Plastic Bottoms - (material) (depth)
 (size) If telescope see back.
 - (5) screen 6' 10 2' (length) (depth to top)
 4" Plastic (size) (material)
 - (6) pump Red Kump (HP) (yield gpm)
 (type power)
 - (7) electric log NO (yes or no)
 (organization running log)

(8) how well bottom plugged
 Wood Plug
 DRILLERS REMARKS:
 old well dug

MAY 14 1970
 MISS. Bd. of
 WATER COMMISSIONERS

If well telescopes please sketch and show depths.

GROUND LEVEL

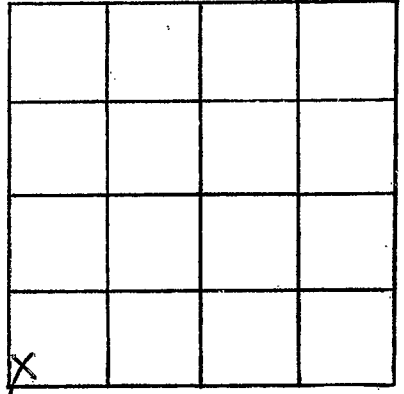

SECTION 15

Please indicate well location X.

ADDITIONAL INFORMATION

If more than one screen,
show locations of each on sketch.