

PIKE
H 54
7-29-70

MISSISSIPPI
BOARD OF WATER COMMISSIONERS
416 North State Street
Jackson, Mississippi 39201

CODED

WATER WELL DRILLERS LOG

29 July 1970 J.T. Cumpston & Son Pike
date well completed firm name county well located

LANDOWNER:
Bruce Brown
Magnolia Rt. 1
(mailing address)

description of formations encountered	from	to
Clay	0	20
Chalk	20	60
Chalk + Rocks	60	80
Sand + Gravel	80	128

WELL LOCATION:
sec. 14 T 2 N R 8 E
5 miles East of Magnolia
(distance) (direction) (nearest town)

WELL PURPOSE: Home
(home, irrigation, municipal, industrial)

- WELL COMPLETION DATA:
- (1) diameter (inches) 4
 - (2) total depth (feet) 128
 - (3) static water level (feet) 80 below top of ground.
 - (4) casing (material) PL (depth) 122
 - (size) if telescope see back.
 - (5) screen (length) 6 (depth to top) 122
 - (size) (material)
 - (6) pump (HP) 1/2 (yield gpm) 12
 - (type power) Eket
 - (7) electric log (yes or no)
 - (organization running log)
 - (8) how well bottom plugged Wood


CODED

SEP 10 1970

DRILLERS REMARKS:

If well telescopes please sketch and show depths.

GROUND LEVEL

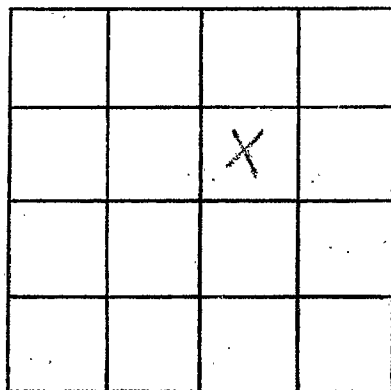

SECTION 14

Please indicate well location X.

ADDITIONAL INFORMATION

If more than one screen,
show locations of each on sketch.