

PIKE
H 55
7-6-70

MISSISSIPPI
BOARD OF WATER COMMISSIONERS
416 North State Street
Jackson, Mississippi 39201

CODED

WATER WELL DRILLERS LOG

July 6 1970 Chester News Pike
date well completed firm name county well located

LANDOWNER: George Conroy
H-1, Mapaholic (mailing address)

description of formations encountered	from	to
	Clay	0
Red sandy chalk	10	20
Red sand	20	25
Sand & gravel	25	40

WELL LOCATION:
sec. 28 T. 20 N. R. 8 E
4 miles SE of Mapaholic (distance) (direction) (nearest town)

WELL PURPOSE: Home (home, irrigation, municipal, industrial)

WELL COMPLETION DATA:

- (1) diameter (inches) 4
- (2) total depth (feet) 90
- (3) static water level (feet) 79 below top of ground
- (4) casing Plastic battery (material) (depth)
- (size) If telescope see back.
- (5) screen 6' 73" (length) (depth to top)
- 4 1/2" Plastic (size) (material)
- (6) pump 1/2 HP (HP) 1000 (yield gpm)
- (type power)
- (7) electric log no (yes or no)
- (organization running log)

CODED


(8) how well bottom plugged
wool
DRILLERS REMARKS: New house

SEP 15 1970

MISS. BD. OF
WATER COMM.

If well telescopes please sketch and show depths.

GROUND LEVEL

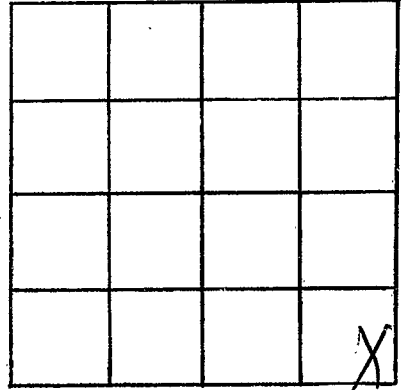

SECTION *28*

Please indicate well location X.

ADDITIONAL INFORMATION

If more than one screen,
show locations of each on sketch.