

Pike
H 56
5-25-70

MISSISSIPPI
BOARD OF WATER COMMISSIONERS
416 North State Street
Jackson, Mississippi 39201

CODED

WATER WELL DRILLERS LOG

May 25 1970 Chester Deane Pike
date well completed firm name county well located

LANDOWNER: Moses Dillon
RT-1 Memphis
(mailing address)

| description of formations encountered | from | to |
|---------------------------------------|-----------|-----------|
| <u>bed clay</u> | <u>0</u> | <u>16</u> |
| <u>bed sand</u> | <u>16</u> | <u>47</u> |
| <u>sand gravel</u> | <u>47</u> | <u>62</u> |
| <u>brink chalk</u> | <u>62</u> | <u>87</u> |
| <u>small gravel sand</u> | <u>87</u> | <u>97</u> |

WELL LOCATION: SW 1/4 SE 1/4
sec. 5 T. 20 N. R. 8 E
3 miles SE of Farmington
(distance) (direction) (nearest town)

WELL PURPOSE: Hand
(home, irrigation, municipal, industrial)

- WELL COMPLETION DATA:
- (1) diameter (inches) 4 1/2"
 - (2) total depth (feet) 97
 - (3) static water level (feet) 47 below above top of ground.
 - (4) casing plastic bottom
(material) (depth)
 - (size) if telescope see back.
 - (5) screen 6' 9'
(length) (depth to top)
 - 4" plastic
(size) (material)
 - (6) pump 3 sub 12
(HP) (yield gpm)
 - elect
(type power)
 - (7) electric log no
(yes or no)
 - (organization running log)

CODED


(8) how well bottom plugged
wood plug
DRILLERS REMARKS: well bad

JUL 24 1970

MISS. BD. OF
WATER COMM.

If well telescopes please sketch and show depths.

GROUND LEVEL

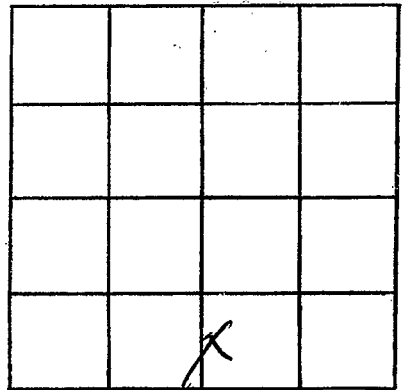

SECTION 5

Please indicate well location X.

ADDITIONAL INFORMATION

If more than one screen, show locations of each on sketch.