

Pike
 H 57
 5-26-70

MISSISSIPPI
 BOARD OF WATER COMMISSIONERS
 416 North State Street
 Jackson, Mississippi 39201

CODED

WATER WELL DRILLERS LOG

May 26 1970 Chester Kelce Pike
 date well completed firm name county well located

LANDOWNER: James Rhodes
RFD Memphis
 (mailing address)

WELL LOCATION:
 sec. 31 T. 2 N. R. 4 E
4 miles SSW of Memphis
 (distance) (direction) (nearest town)

WELL PURPOSE: farm
 (home, irrigation, municipal, industrial)

- WELL COMPLETION DATA:
- (1) diameter (inches) 4"
 - (2) total depth (feet) 98
 - (3) static water level (feet) 67 below above top of ground.
 - (4) casing Plastic Ballam
 (material) (depth)
 - (size) if telescope see back.
 - (5) screen 6' 92'
 (length) (depth to top)
 - 4" Plastic
 (size) (material)
 - (6) pump Byars
 (HP) (yield gpm)
 - (type power)
 - (7) electric log No
 (yes or no)
 - (organization running log)
 - (8) how well bottom plugged wood plug

description of formations encountered	from	to
	<u>bed clay</u>	<u>0</u>
<u>red sand</u>	<u>15</u>	<u>35</u>
<u>sand & gravel</u>	<u>35</u>	<u>65</u>
<u>red black</u>	<u>65</u>	<u>73</u>
<u>sand & gravel</u>	<u>73</u>	<u>98</u>

CODED


DRILLERS REMARKS:
new location

III 27 1970

MISSISSIPPI BOARD OF WATER COMMISSIONERS

If well telescopes please sketch and show depths.

GROUND LEVEL

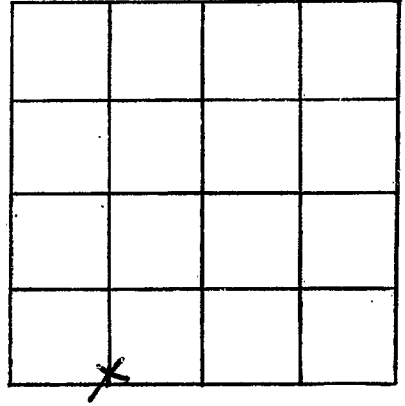

SECTION 31

Please indicate well location X.

ADDITIONAL INFORMATION

If more than one screen,
show locations of each on sketch.