

PIKE
H60
7-29-70

MISSISSIPPI
BOARD OF WATER COMMISSIONERS
416 North State Street
Jackson, Mississippi 39201

CODED

WATER WELL DRILLERS LOG

79562 1970 J. St. ... Pike
date well completed firm name county well located

LANDOWNER:
Rosa Hall Waring
Magnolia
(mailing address)

description of formations encountered	from	to
Clay	0	20
Chalky Sand	20	45
Sand Chalk	45	65
Sand Gravel	65	80

WELL LOCATION:
sec. 5 T 2 N R 8 E
3 miles East of Fenwick
(distance) (direction) (nearest town)

WELL PURPOSE: Home
(home, irrigation, municipal, industrial)

- WELL COMPLETION DATA:
- (1) diameter (inches) 4 80
 - (2) total depth (feet) 80
 - (3) static water level (feet) 55 below above top of ground.
 - (4) casing (material) 4" (depth) 74
 - (size) If telescope see back.
 - (5) screen (length) 6' (depth to top) 74
 - (size) 4" (material) 4"
 - (6) pump (HP) 1/2 (yield gpm) 6
 - (type power) Elect
 - (7) electric log (yes or no)

CODED

(organization running log)

(8) how well bottom plugged wood


AUG 7 1970

DRILLERS REMARKS:

MISS. BD. OF
WATER COMMISSIONERS

If well telescopes please sketch and show depths.

GROUND LEVEL

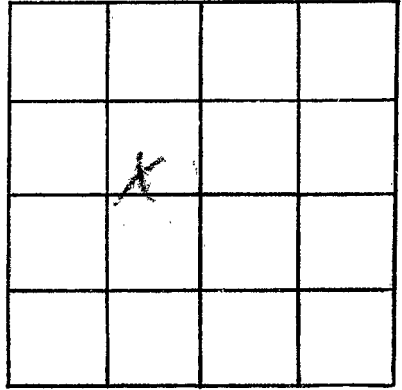

SECTION 5

Please indicate well location X.

ADDITIONAL INFORMATION

If more than one screen, show locations of each on sketch.