

PIKE
H 63
8-7-70

MISSISSIPPI
BOARD OF WATER COMMISSIONERS
416 North State Street
Jackson, Mississippi 39201

CODED

WATER WELL DRILLERS LOG

August 7 1970 J.T. Covington + Son PIKE
date well completed firm name county well located

LANDOWNER: D.L. PRICE
Summit, Miss
(mailing address)

description of formations encountered	from	to
Clay	0	40
Chalk	40	80
Sand + Gravel	80	100
Chalk	100	120
Sand + Gravel	120	140

WELL LOCATION:
sec. 9 T 2 N R 8 E
5 miles East of Magnolia
(distance) (direction) (nearest town)

WELL PURPOSE: Home
(home, irrigation, municipal, industrial)

- WELL COMPLETION DATA:
- (1) diameter (inches) 4"
 - (2) total depth (feet) 140
 - (3) static water level (feet) 90 below top of ground.
 - (4) casing (material) pl (depth) 134
(size) If telescope see back.
 - (5) screen (length) 6' (depth to top) 134
(size) 4 (material) pl
 - (6) pump (HP) 1/2 (yield gpm) 12
Elect (type power)
 - (7) electric log (yes or no)
 - (organization running log)
 - (8) how well bottom plugged Wood

CODED


OCT 13 1970

DRILLERS REMARKS:

MISS. BD. OF
WATER COMM.

If well telescopes please sketch and show depths.

GROUND LEVEL

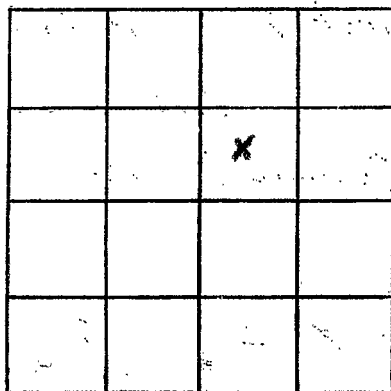

SECTION 9

Please indicate well location X.

ADDITIONAL INFORMATION

If more than one screen, show locations of each on sketch.