

PIKE
H64
8-21-70

MISSISSIPPI
BOARD OF WATER COMMISSIONERS
416 North State Street
Jackson, Mississippi 39201

CODED

WATER WELL DRILLERS LOG

August 21 1970 J.T. Conington & Son Pipe
date well completed firm name county/well located

LANDOWNER:
Casey Johnson
Magnolia Miss
(mailing address)

| description of formations encountered | from | to |
|---------------------------------------|------|----|
| Clay | 0 | 30 |
| Sand | 30 | 60 |
| Sand + Gravel | 60 | 88 |

WELL LOCATION:
sec 11 T 2 N R 8 E
4 1/2 miles East of Magnolia
(distance) (direction) (nearest town)

WELL PURPOSE: Home
(home, irrigation, municipal, industrial)

- WELL COMPLETION DATA:
- (1) diameter (inches) 4"
 - (2) total depth (feet) 88'
 - (3) static water level (feet) 60 below top of ground
 - (4) casing P1 (material) 82 (depth)
 - (5) screen 6' (length) 82 (depth to top)
 - (6) pump 1/2 (HP) 6 (yield gpm)
 - (7) electric log No (yes or no)

CODED

(organization running log)
(8) how well bottom plugged Wood


OCT 13 1970

DRILLERS REMARKS:

MISS. BD. OF
WATER COMM.

If well telescopes please sketch and show depths.

GROUND LEVEL

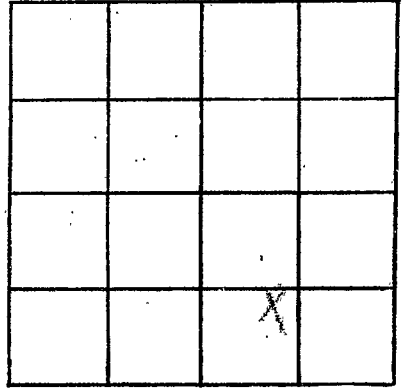

SECTION 11

Please indicate well location X.

ADDITIONAL INFORMATION

If more than one screen, show locations of each on sketch.