

PIKE
H 65
9-1-70

MISSISSIPPI
BOARD OF WATER COMMISSIONERS
416 North State Street
Jackson, Mississippi 39201

CODED

WATER WELL DRILLERS LOG

Sept 1 1970 Chester Keener Pike
date well completed firm name county well located

LANDOWNER: Samuel Patterson
RT-1, Magnolia
(mailing address)

description of formations encountered	from	to
<u>Silt clay</u>	<u>0</u>	<u>17</u>
<u>Red sand gravel</u>	<u>17</u>	<u>71</u>
<u>Gravel & sand</u>	<u>71</u>	<u>95</u>

WELL LOCATION:
sec. 27 T 2 N R. 8 E
5 miles SE of Magnolia
(distance) (direction) (nearest town)

WELL PURPOSE: Home
(home, irrigation, municipal, industrial)

WELL COMPLETION DATA:

- (1) diameter (inches) 4"
- (2) total depth (feet) 95
- (3) static water level (feet) 75 below top of ground.
- (4) casing Plastic (material) Bottom (depth)
- (size) if telescope see back.
- (5) screen 6' (length) 89' (depth to top)
- 4" (size) Plastic (material)
- (6) pump 1/2 hp (HP) 5 (yield gpm)
- Electric (type power)
- (7) electric log no (yes or no)
- (organization running log)

CODED

(8) how well bottom plugged wooden plug


DRILLERS REMARKS: New location

OCT 14 1970

MISS. RD. OF
WATER COMMISSIONERS

If well telescopes please sketch and show depths.

GROUND LEVEL

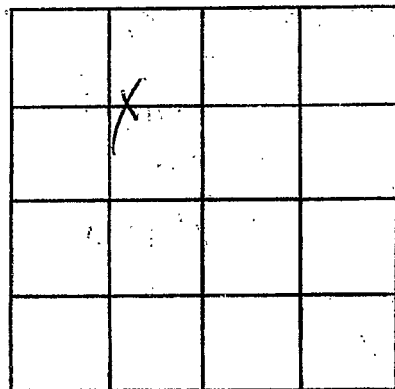

SECTION 27

Please indicate well location X.

ADDITIONAL INFORMATION

If more than one screen,
show locations of each on sketch.