

PIKE
H 66
9-18-70

MISSISSIPPI
BOARD OF WATER COMMISSIONERS
416 North State Street
Jackson, Mississippi 39201

CODED

WATER WELL DRILLERS LOG

Sept 18 70 date well completed
chesterkeens firm name
Pike county well located

LANDOWNER: LLOYD
ELEMINE
PFD, MAPALINA
(mailing address)

description of formations encountered	from	to
red clay	0	12
red sand	12	48
sand & clay gravel	48	72
sand & rock	72	73
small gravel sand	73	88

WELL LOCATION:
sec. 34 T. 20 N. R. 5 E
6 miles SE of Mapalina
(distance) (direction) (nearest town)

WELL PURPOSE: drain
(home, irrigation, municipal, industrial)

- WELL COMPLETION DATA:
- (1) diameter (inches) 4 1/2"
 - (2) total depth (feet) 88
 - (3) static water level (feet) 77 below/above top of ground.
 - (4) casing Plastic Ballank
(material) (depth)
 - (size) if telescope see back.
 - (5) screen 6' 82'
(length) (depth to top)
 - (size) (material) Plastic
 - (6) pump sump installed
(HP) (yield gpm)
by a well
(type power)
 - (7) electric log No
(yes or no)
 - (organization running log)

CODED

(8) how well bottom plugged
wood plug


DRILLERS REMARKS:
new house

NOV 12 1970

MISS. Bd. of
WATER COMMISSIONERS

If well telescopes please sketch and show depths.

GROUND LEVEL

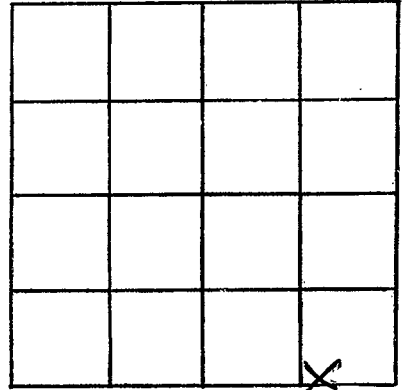

SECTION 34

Please indicate well location X.

ADDITIONAL INFORMATION

If more than one screen,
show locations of each on sketch.