

PIKE
H 67
9-29-70

MISSISSIPPI
BOARD OF WATER COMMISSIONERS
416 North State Street
Jackson, Mississippi 39201

CODED

WATER WELL DRILLERS LOG

Sept 29, 1970 Chester Reeves Pike
date well completed firm name county well located

LANDOWNER: Judge Witham

description of formations encountered

from to

RFD Magnolia
(mailing address)

clay	0	15
sand	15	40
chalk	40	80
sand & gravel	80	101

WELL LOCATION:

sec. 29 T. 2 N. R. 8 E
4 miles SE Magnolia
(distance) (direction) (nearest town)

WELL PURPOSE: drinking
(home, irrigation, municipal, industrial)

WELL COMPLETION DATA:

- (1) diameter (inches) 4"
- (2) total depth (feet) 101
- (3) static water level (feet) 91 below top of ground.
- (4) casing Asbestos (material) 101 (depth)
- (5) screen 6' (length) 95' (depth to top)
4" (size) plastic (material)
- (6) pump 1/2 (HP) 12 (yield gpm)
elect (type power)
- (7) electric log No (yes or no)

CODED

(organization running log)

(8) how well bottom plugged wood plug


DRILLERS REMARKS: New house

NOV 12 1970

MISS. BD. OF
WATER COMMISSIONERS

If well telescopes please sketch and show depths.

GROUND LEVEL

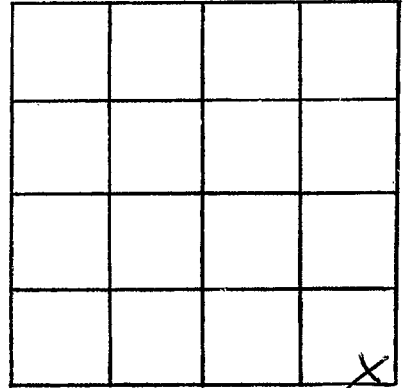

SECTION 29

Please indicate well location X.

ADDITIONAL INFORMATION

If more than one screen, show locations of each on sketch.