

PIKE  
H 68  
1-16-67

MISSISSIPPI  
BOARD OF WATER COMMISSIONERS  
416 North State Street  
Jackson, Mississippi 39201

**CODED**

WATER WELL DRILLERS LOG

1-16 date well completed  
1967 firm name  
19 Magnolia Water Well Pike county well located

LANDOWNER: Lizziet H Ford  
Magnolia Rd Miss  
(mailing address)

description of formations encountered	from	to
top soil & clay	0	18
Red Sand	18	35
Chalk	35	70
Sand	70	78
gravel	78	85
Chalk	85	90
fine sand	90	108
gravel & sand	108	122

WELL LOCATION:  
sec. 18 T. 2 N. R. 8 E.  
S. W.  
7 miles SE of Magnolia  
(distance) (direction) (nearest town)

WELL PURPOSE: home  
(home, irrigation, municipal, industrial)

WELL COMPLETION DATA:

(1) diameter (inches) 4

(2) total depth (feet) 122

(3) static water level (feet) 87 below above top of ground.

(4) casing plastic 1 1/2  
(material) (depth)  
4 if telescope see back.  
(size)

(5) screen 6' 1 1/2  
(length) (depth to top)  
4 plastic  
(size) (material)

(6) pump 1 Set 10  
(HP) (yield gpm)  
Spec  
(type power)


(7) electric log no  
(yes or no)

**CODED**

(organization running log)


(8) how well bottom plugged plugged

DRILLERS REMARKS:

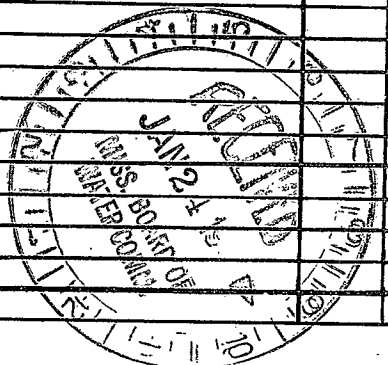

If well telescopes please sketch and show depths.

GROUND LEVEL

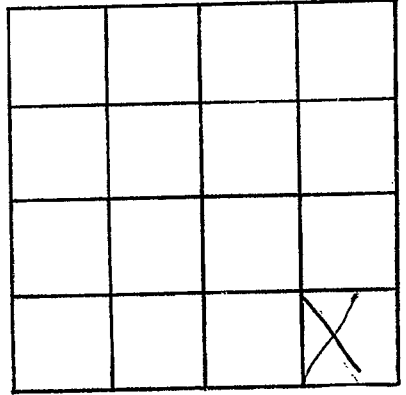

SECTION 18

Please indicate well location X.

ADDITIONAL INFORMATION

If more than one screen, show locations of each on sketch.