

PIKE
H69
9-26-70

MISSISSIPPI
BOARD OF WATER COMMISSIONERS
416 North State Street
Jackson, Mississippi 39201

CODED

WATER WELL DRILLERS LOG

26 Sept. 1970 J.T. Covington & Son Pike
date well completed firm name county well located

LANDOWNER:	description of formations encountered	from	to
Lynn Simmons Magnolia, Miss (mailing address)			
WELL LOCATION:			
sec. 22 T. 2 N. R. 8 E. 5 miles East of Magnolia (distance) (direction) (nearest town)			
WELL PURPOSE: Home (home, irrigation, municipal, industrial)			
WELL COMPLETION DATA:			
(1) diameter (inches) 4"			
(2) total depth (feet) 98'			
(3) static water level (feet) 60 below top of ground.			
(4) casing pl. 92' (material) (depth)			
(size) If telescope see back.			
(5) screen 6' 92' (length) (depth to top)			
(size) (material)			
(6) pump 1/2 6 (HP) (yield gpm)			
(type power) elect			
(7) electric log No (yes or no)			
(organization running log)			
(8) how well bottom plugged wood			
DRILLERS REMARKS:			


CODED

DEC 11 1970

MISS. BD. OF
WATER COMM.

If well telescopes please sketch and show depths.

GROUND LEVEL

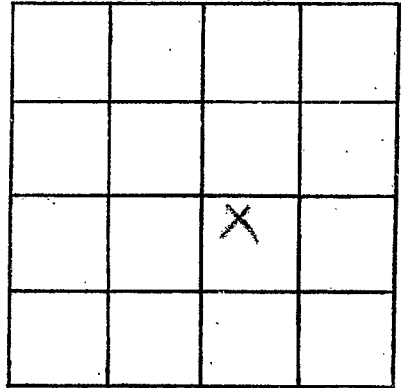

SECTION 22

Please indicate well location X.

ADDITIONAL INFORMATION

If more than one screen,
show locations of each on sketch.