

PIKE  
H 70  
12-17-70

MISSISSIPPI  
BOARD OF WATER COMMISSIONERS  
416 North State Street  
Jackson, Mississippi 39201

**CODED**

WATER WELL DRILLERS LOG

12-17 1970 date well completed  
Fitzgerald Sewer Pipe firm name  
Pike county well located

LANDOWNER:  
Albert Pounds  
P.O. 3 McComb, Miss.  
(mailing address)

description of formations encountered	from	to
Red Clay	0	20
Red sand	20	60
Coarse sand & gravel	60	83

WELL LOCATION:  
sec. 36 T. 20<sup>N</sup> R. 8<sup>E</sup>  
S W  
3 miles N of Piquemore  
(distance) (direction) (nearest town)

WELL PURPOSE: Home  
(home, irrigation, municipal, industrial)

WELL COMPLETION DATA:

(1) diameter (inches) 4

(2) total depth (feet) 83

(3) static water level (feet) 70 below top of ground.

(4) casing plastic, 77 (material) (depth)  
4 (size) if telescope see back.

(5) screen 6, 77 (length) (depth to top)  
7, plastic (size) (material)

(6) pump 1 (HP) 7 (yield gpm)  
Elec (type power)

(7) electric log No (yes or no)  
(organization running log)

(8) how well bottom plugged Wood Peg

**CODED**


JAN 21 1971

MISS. BD. OF  
WATER COMM.

DRILLERS REMARKS:

If well telescopes please sketch and show depths.

GROUND LEVEL

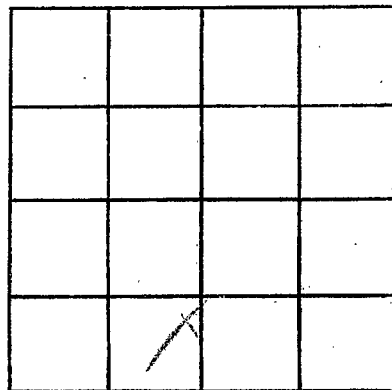

SECTION 36

Please indicate well location X.

ADDITIONAL INFORMATION

If more than one screen,  
show locations of each on sketch.