

PIKE

H 72

5-8-69

MISSISSIPPI
 BOARD OF WATER COMMISSIONERS
 416 North State Street
 Jackson, Mississippi 39201

CODED

WATER WELL DRILLERS LOG

May 8 1969
date well completed

Keenesack & Pump Co.
firm name

PIKE
county well located

LANDOWNER

Tom Collins

description of formations encountered

from to

RFD 1
Mapolia
(mailing address)

yellow sandy clay	0	16
Sand & small gravel	16	28
Gravel	28	96
Red chalk	96	99
Red gravel band	99	110

WELL LOCATION:

sec. 9 T. 2 N. R. 8 E
3 miles NE of Mapolia
(distance) (direction) (nearest town)

WELL PURPOSE: Home
(home, irrigation, municipal, industrial)

WELL COMPLETION DATA:

- (1) diameter (inches) 4"
- (2) total depth (feet) 110
- (3) static water level (feet) 40 below top of ground
- (4) casing Plastic Ballroom (material) (depth)
- (size) if telescope see back.
- (5) screen 6' 104" (length) (depth to top)
1/2" Plastic (size) (material)
- (6) pump 1/2 HP (type power) (yield gpm)
- (7) electric log NO (yes or no)

CODED

(organization running log)

(8) how well bottom plugged
wooden plug


DRILLERS REMARKS:
new house.

APR 15 1969

Mississippi State Board of Water Commissioners

If well telescopes please sketch and show depths.

GROUND LEVEL

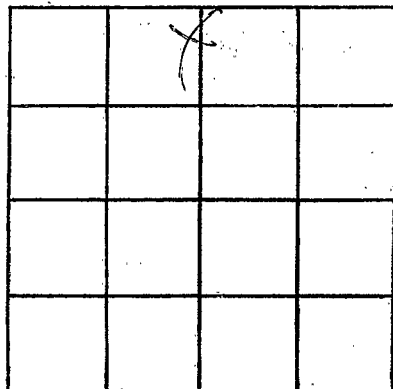

SECTION 9

Please indicate well location X.

ADDITIONAL INFORMATION

If more than one screen,
show locations of each on sketch.