

PIKE
H 73
6-17-69

MISSISSIPPI
BOARD OF WATER COMMISSIONERS
416 North State Street
Jackson, Mississippi 39201

CODED

WATER WELL DRILLERS LOG

June 17 1969 *Reynolds & Dunlap, Pike*
date well completed firm name county well located

LANDOWNER: *Paul Dikau Rt-1, Mapaha*
(mailing address)

description of formations encountered	from	to
<i>bed clay</i>	<i>0</i>	<i>13</i>
<i>red sand</i>	<i>13</i>	<i>29</i>
<i>sand & gravel</i>	<i>29</i>	<i>58</i>
<i>blue chalk</i>	<i>38</i>	<i>67</i>
<i>gravel & sand</i>	<i>67</i>	<i>82</i>

WELL LOCATION:
sec. *8* T. *2* N. R. *8* E
2 miles *NE* - *Mapaha*
(distance) (direction) (nearest town)

WELL PURPOSE: *Home*
(home, irrigation, municipal, industrial)

WELL COMPLETION DATA:

- (1) diameter (inches) *4 1/2"*
- (2) total depth (feet) *82*
- (3) static water level (feet) *50* below top of ground.
- (4) casing *Plastic, Galvan*
(material) (depth)
- (size) if telescope see back
- (5) screen *6'* *76'*
(length) (depth to top)
- 4"* *Plastic*
(size) (material)
- (6) pump *1/2 Sub-12*
(HP) (yield gpm)
- Steel*
(type power)
- (7) electric log *No*
(yes or no)

(organization running log)

(8) how well bottom plugged
wooden plug

DRILLERS REMARKS:


CODED

809 2 8 1969

MISS. Bd. of
WATER COMMISSIONERS

If well telescopes please sketch and show depths.

GROUND LEVEL

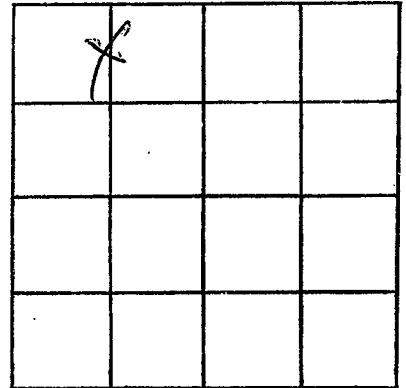

SECTION 8

Please indicate well location X.

ADDITIONAL INFORMATION

If more than one screen,
show locations of each on sketch.