

PIKE
H 74
7-10-69

MISSISSIPPI
BOARD OF WATER COMMISSIONERS
416 North State Street
Jackson, Mississippi 39201

CODED

WATER WELL DRILLERS LOG

10 July 1969 J. T. Covington Son P. K. P.
date well completed firm name county well located

LANDOWNER:

Philip O'Brian

Memphis
(mailing address)

WELL LOCATION:

sec. 31 T. 2 N R. 8 E
6 miles South of Memphis
(distance) (direction) (nearest town)

WELL PURPOSE: Home
(home, irrigation, municipal, industrial)

WELL COMPLETION DATA:

- (1) diameter (inches) 4"
- (2) total depth (feet) 130
- (3) static water level (feet) 70 below top of ground.
- (4) casing Plastic 130
(material) (depth)
(size) if telescope see back.
- (5) screen 6 124
(length) (depth to top)
4 Plastic
(size) (material)
- (6) pump 1 8
(HP) (yield gpm)
Elect
(type power)
- (7) electric log _____
(yes or no)
(organization running log)
- (8) how well bottom plugged wood

description of formations encountered

from to

Clay	0	35
Chalk	35	60
Sand	60	80
Chalk	80	95
Sand	95	130

CODED


AUG 25 1969

MISSISSIPPI BOARD OF WATER COMMISSIONERS

DRILLERS REMARKS:

If well telescopes please sketch and show depths.

GROUND LEVEL

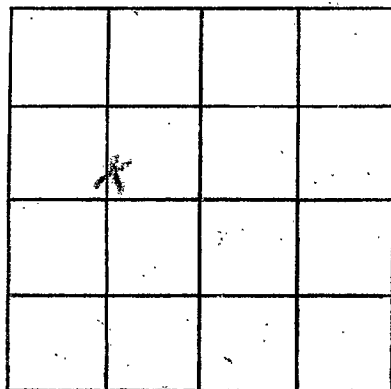

SECTION 31

Please indicate well location X.

ADDITIONAL INFORMATION

If more than one screen,
show locations of each on sketch.