

MISSISSIPPI
BOARD OF WATER COMMISSIONERS
416 North State Street
Jackson, Mississippi 39201

CODED

WATER WELL DRILLERS LOG

PKR
75
7-17-69

July 17 1969 James Well Drilling Co. PKR
date well completed firm name county well located

LANDOWNER: JAMES BARNES
AD 1, Magnolia
(mailing address)

WELL LOCATION:
sec. 7 T 2 N R 8 E
7 miles SE McComb
(distance) (direction) (nearest town)

WELL PURPOSE: Home
(home, irrigation, municipal, industrial)

WELL COMPLETION DATA:

(1) diameter (inches) 4"

(2) total depth (feet) 130

(3) static water level (feet) 105 below top of ground. above

(4) casing Plastic, 6" dia
(material) (depth)

 if telescope see back.
(size)

(5) screen 6' 124
(length) (depth to top)

4" Plastic
(size) (material)

(6) pump 1/2 510-17
(HP) (yield gpm)

Elect.
(type power)

(7) electric log NO
(yes-or-no)

(organization running log)

description of formations encountered	from	to
<u>Red Clay</u>	<u>0</u>	<u>23</u>
<u>Red Sand Turb</u>		
<u>Small gravel</u>	<u>23</u>	<u>87</u>
<u>Red Sandy chaff</u>	<u>87</u>	<u>117</u>
<u>Small gravel and coarse sand</u>	<u>117</u>	<u>130</u>

CODED


(8) how well bottom plugged wooden plug

DRILLERS REMARKS: New house

SEP 28 1969
569
SD. OF

If well telescopes please sketch and show depths.

GROUND LEVEL

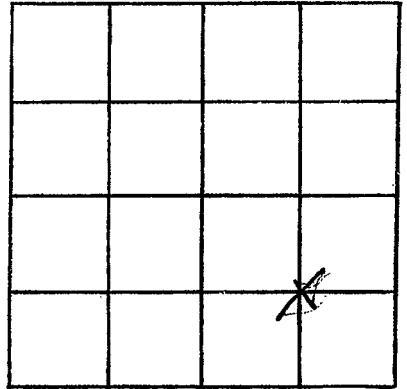

SECTION 1

Please indicate well location X.

ADDITIONAL INFORMATION

If more than one screen,
show locations of each on sketch.