

PIKE  
H 76  
7-18-69

MISSISSIPPI  
BOARD OF WATER COMMISSIONERS  
416 North State Street  
Jackson, Mississippi 39201

**CODED**

WATER WELL DRILLERS LOG

Pike

18 July 1969 data well completed by J.T. Co. firm name county well located

LANDOWNER:  
Salmag Varnado  
Mapuchia  
(mailing address)

description of formations encountered	from	to
Clay	0	35
Clay sand	35	60
Chalk sand	55	70
Sand	70	95

WELL LOCATION:  
sec. 31 T 2 N R 8 E  
6 miles South of Mapuchia  
(distance) (direction) (nearest town)

WELL PURPOSE:  
(home, irrigation, municipal, industrial)

- WELL COMPLETION DATA:
- (1) diameter (inches) 4"
  - (2) total depth (feet) 95
  - (3) static water level (feet) 65 below top of ground.
  - (4) casing Plastic, 95 (material) (depth)
  - (size) if telescope see back.
  - (5) screen 6' 89 (length) (depth to top)
  - 4" Plastic (size) (material)
  - (6) pump 1/2 5 (HP) (yield gpm)
  - elect. (type power)
  - (7) electric log (yes or no)

**CODED**

(organization running log)

(8) how well bottom plugged wood


AUG 25 1969

DRILLERS REMARKS:

MISS. BD. OF WATER COMMISSIONERS

If well telescopes please sketch and show depths.

GROUND LEVEL

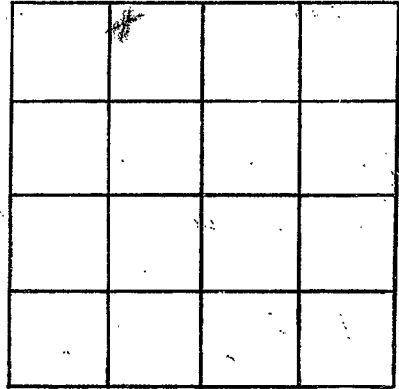

SECTION \_\_\_\_\_

Please indicate well location X.

ADDITIONAL INFORMATION

If more than one screen,  
show locations of each on sketch.