

MISSISSIPPI
BOARD OF WATER COMMISSIONERS
416 North State Street
Jackson, Mississippi 39201

CODED

WATER WELL DRILLERS LOG

PIKE
A 77
8-5-69

Aug 5 1969 Keenwell Drillers Pike
date well completed firm name county well located

LANDOWNER: Walter Dancer
RFD 1, Box 263
Mt. Laurel
(mailing address)

WELL LOCATION:
sec. 4 T. 2 N. R. 5 E
3 miles SE of Fernand
(distance) (direction) (nearest town)

WELL PURPOSE: Home
(home, irrigation, municipal, industrial)

WELL COMPLETION DATA:

- (1) diameter (inches) 4 ^{ft}
- (2) total depth (feet) 116
- (3) static water level (feet) 103 ^{below} ~~above~~ top of ground.
- (4) casing Plastic Galvan
(material) (depth)
- (size) if telescope see back.
- (5) screen 6' 110'
(length) (depth to top)
- 4" Plastic
(size) (material)
- (6) pump 1 HP 5
(HP) (yield gpm)
- Elect
(type power)
- (7) electric log no
(yes or no)

(organization running log)


(8) how well bottom plugged wooden plug

DRILLERS REMARKS:
old 2" well log

description of formations encountered	from	to
<u>Red clay</u>	<u>0</u>	<u>25</u>
<u>Mud sand & gravel</u>	<u>25</u>	<u>98</u>
<u>Sand & gravel</u>	<u>98</u>	<u>116</u>
CODED		
SEP 25 1969		
MISS. Bd. of WATER COMMISSIONERS		

If well telescopes please sketch and show depths.

GROUND LEVEL

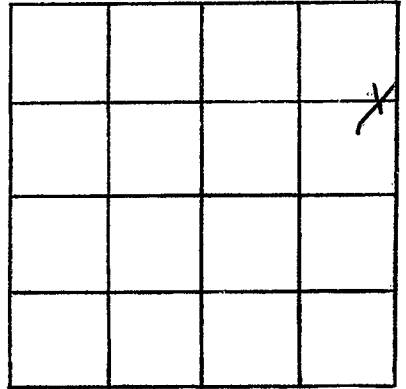

SECTION 42

Please indicate well location X.

ADDITIONAL INFORMATION

If more than one screen,
show locations of each on sketch.