

MISSISSIPPI
 BOARD OF WATER COMMISSIONERS
 416 North State Street
 Jackson, Mississippi 39201

CODED

WATER WELL DRILLERS LOG

DIKE
 H 78
 8-29-69

Aug 24 1969 *Sevens Well Drilling* *Pike*
 date well completed firm name county well located

LANDOWNER: *A.C. Sandifer*

RFD #1
Maple
 (mailing address)

WELL LOCATION:
 sec. *8* T *2* N R *9* E
2 miles *ENE* of *Maple*
 (distance) (direction) (nearest town)

WELL PURPOSE: *Domestic*
 (home, irrigation, municipal, industrial)

WELL COMPLETION DATA:

- (1) diameter (inches) *4"*
- (2) total depth (feet) *12.5*
- (3) static water level (feet) *70* below top of ground. ~~above~~
- (4) casing *Plastic, Ballston*
 (material) (depth)

- (5) screen *6'* *119'*
 (length) (depth to top)
- 4"* *Plastic*
 (size) (material)

- (6) pump *used old pump*
 (HP) (yield gpm)
- elect.*
 (type power)

- (7) electric log *NO*
 (yes or no)

(organization running log)

- (8) how well bottom plugged *wooden plug*

DRILLERS REMARKS:
old well filled with sand

description of formations encountered	from	to
<i>clay & gravel</i>	<i>0</i>	<i>16</i>
<i>Red Sand & chalk</i>	<i>16</i>	<i>82</i>
<i>Small gravel</i>	<i>82</i>	<i>86</i>
<i>Sandy sand & chalk</i>	<i>86</i>	<i>116</i>
<i>Coarse Sand</i>	<i>116</i>	<i>125</i>


CODED

SEP 24 1969

MISSISSIPPI BOARD OF WATER COMMISSIONERS

If well telescopes please sketch and show depths.

GROUND LEVEL

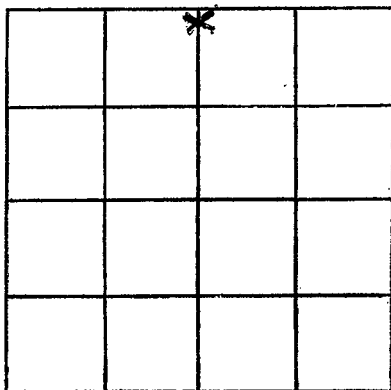

SECTION 8

Please indicate well location X.

ADDITIONAL INFORMATION

If more than one screen,
show locations of each on sketch.