

MISSISSIPPI  
BOARD OF WATER COMMISSIONERS  
416 North State Street  
Jackson, Mississippi 39201

**CODED**

**WATER WELL DRILLERS LOG**

Pike  
H-79  
9-9-69

9-9

19

69

Fitzgerald & Son

firm name

Pike

county well located

**LANDOWNER:**

Henry Clay

R.R. McComb, Miss.  
(mailing address)

**WELL LOCATION:**

sec. 5 T 2 N R 8 E

3 miles NW of Magruder  
(distance) (direction) (nearest town)

**WELL PURPOSE:**

(home, irrigation, municipal, industrial)

**WELL COMPLETION DATA:**

- (1) diameter (inches) 4  
(2) total depth (feet) 122  
(3) static water level (feet) 70 below above top of ground.

- (4) casing plastic 116  
(material) (depth)

4 if telescope see back.  
(size)

- (5) screen 6 116  
(length) (depth to top)

4 plastic  
(size) (material)

- (6) pump 1/2 12  
(HP) (yield gpm)

electric  
(type power)

- (7) electric log no  
(yes or no)

(organization running log)

- (8) how well bottom plugged wood peg

**DRILLERS REMARKS:**

description of formations encountered

from

to

Red Clay 0 20

Red Sand 20 60

Red gravel 60 74

Fine Sand 74 110

Coarse Sand & gravel 110 122


**CODED**

SEP 10 1969

MISSISSIPPI  
BOARD OF WATER COMMISSIONERS

If well telescopes please  
sketch and show depths.

GROUND LEVEL

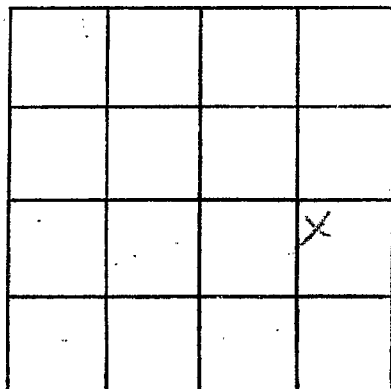

SECTION 5

Please indicate well location X.

ADDITIONAL INFORMATION

If more than one screen,  
show locations of each on sketch.