

PIKE
H80
1-2-70

MISSISSIPPI
BOARD OF WATER COMMISSIONERS
416 North State Street
Jackson, Mississippi 39201

CODED

WATER WELL DRILLERS LOG

2 Jan. 1970 J.T. Cunningham Son Pike
date well completed firm name county well located

LANDOWNER:
H. C. Rebold
Magnolia
(mailing address)

description of formations encountered	from	to
Clay	0	25
Gravelly clay	25	40
Reddish clay	40	65
Sandy gravel	65	90
Chalky sand	90	110
Gravel bank	110	135

WELL LOCATION:
sec. 14 T. 2 N R. 8 E
4 miles East of Magnolia
(distance) (direction) (nearest town)

WELL PURPOSE: Home
(home, irrigation, municipal, industrial)

WELL COMPLETION DATA:

(1) diameter (inches) 4

(2) total depth (feet) 135

(3) static water level (feet) 90 ~~above~~ below top of ground.

(4) casing PL, 129 (material) (depth)
(size) if telescope see back.

(5) screen 6, 129 (length) (depth to top)
4, PL (size) (material)

(6) pump 1, 10 (HP) (yield gpm)
ELECT. (type power)

(7) electric log (yes or no)

(organization running log)

(8) how well bottom plugged wood

CODED


FEB 16 1970

MISS. BD. OF
WATER COM.

DRILLERS REMARKS:

If well telescopes please sketch and show depths.

GROUND LEVEL

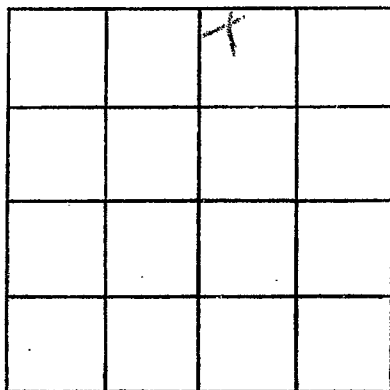

SECTION 14

Please indicate well location X.

ADDITIONAL INFORMATION

If more than one screen, show locations of each on sketch.