

Pike
H 81
1-22-70

MISSISSIPPI
BOARD OF WATER COMMISSIONERS
416 North State Street
Jackson, Mississippi 39201

CODED

WATER WELL DRILLERS LOG

Jan 27 1970 Reems Well Drillers Pike
date well completed firm name county well located

LANDOWNER: Lesley McKenzie
RF 4, Magnolia
(mailing address)

WELL LOCATION:
sec 36 T 2 N R 4 E
7 miles SE of Magnolia
(distance) (direction) (nearest town)

WELL PURPOSE: Home
(home, irrigation, municipal, industrial)

WELL COMPLETION DATA:
(1) diameter (inches) 4"
(2) total depth (feet) 152
(3) static water level (feet) 90 below top of ground. ~~above~~
(4) casing Plastic bottom
(material) (depth)
6' If telescope see back. (size)
(5) screen 146' (length) (depth to top)
14" (size) Plastic (material)
(6) pump 1/2 (HP) (yield gpm)
elect (type power)
(7) electric log NO
(yes or no)
(organization running log)

description of formations encountered	from	to
Red sand	0	12
Washed sand gravel	12	75
Gravel	75	90
Red chert	90	93
Sandy sand	93	145
Red gravel sand	145	152

CODED


FEB 27 1970

MISS. BO. OF WATER COMMISSIONERS

(8) how well bottom plugged working plug
DRILLER'S REMARKS: old well had

If well telescopes please sketch and show depths.

GROUND LEVEL

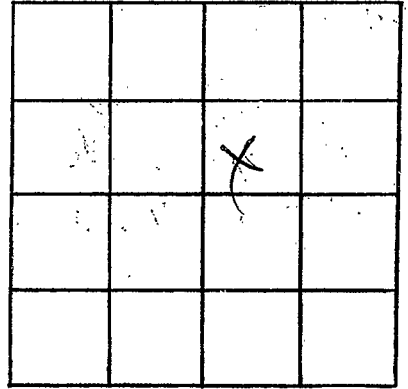

SECTION 30

Please indicate well location X.

ADDITIONAL INFORMATION

If more than one screen, show locations of each on sketch.