

Pike  
H82  
10-16-69

MISSISSIPPI  
 BOARD OF WATER COMMISSIONERS  
 416 North State Street  
 Jackson, Mississippi 39201

**CODED**

WATER WELL DRILLERS LOG

Oct 16 1969 Greenwell Pump Co Pike  
 date well completed firm name county well located

Richard  
Community School -  
RFD, Magnolia  
 (mailing address)

description of formations encountered	from	to
<u>Red clay</u>	<u>0</u>	<u>16</u>
<u>Red sand</u>	<u>16</u>	<u>52</u>
<u>Red sand &amp; gravel</u>	<u>52</u>	<u>80</u>
<u>Small gravel &amp; sand</u>	<u>80</u>	<u>98</u>

WELL LOCATION:  
 sec 28 T 2 N R 4 E  
4 miles SE of Magnolia  
 (distance) (direction) (nearest town)

WELL PURPOSE: school  
 (home, irrigation, municipal, industrial)

- WELL COMPLETION DATA:
- (1) diameter (inches) 4"
  - (2) total depth (feet) 98
  - (3) static water level (feet) 30 below above top of ground.
  - (4) casing Hastie Bottom  
 (material) (depth)
  - (5) screen 6' 92'  
 (length) (depth) to top  
4" Hastie  
 (size) (material)
  - (6) pump 1/2 hp 6  
 (HP) (yield gpm)  
elect  
 (type power)
  - (7) electric log no  
 (yes or no)

**CODED**

(organization running log)


(8) how well bottom plugged  
wooden plug

DRILLERS REMARKS:

DEC 21 1969

If well telescopes please sketch and show depths.

GROUND LEVEL

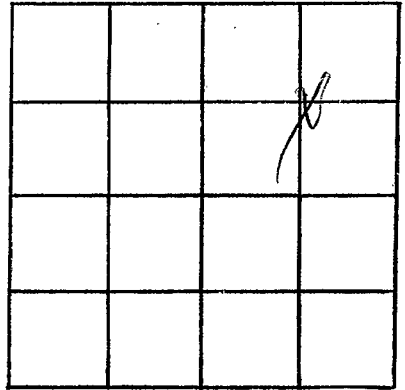

SECTION 28

Please indicate well location X.

ADDITIONAL INFORMATION

If more than one screen,  
show locations of each on sketch.