

MISSISSIPPI
BOARD OF WATER COMMISSIONERS
416 North State Street
Jackson, Mississippi 39201

CODED

WATER WELL DRILLERS LOG

Pike
H83
10-29-69

Oct 29 69 Leves well pump Pike
date well completed firm name county well located

LANDOWNER: Paul Marshall
RT-1, Magnolia
(mailing address)

description of formations encountered	from	to
<u>Red clay</u>	<u>0</u>	<u>15</u>
<u>Red sand</u>	<u>15</u>	<u>50</u>
<u>Red sand & gravel</u>	<u>50</u>	<u>77</u>
<u>Small gravel & sand</u>	<u>77</u>	<u>92</u>

WELL LOCATION:
sec 28 T 2 N R 8 E
4 miles SE of Magnolia
(distance) (direction) (nearest town)

WELL PURPOSE: Home
(home, irrigation, (municipal, industrial))

WELL COMPLETION DATA:

(1) diameter (inches) 4"

(2) total depth (feet) 92

(3) static water level (feet) 75 below above top of ground.

(4) casing Plastic Ballast
(material) (depth)

_____ If telescope see back.
(size)

(5) screen 6' 86'
(length) (depth to top)

4" Plastic
(size) (material)

(6) pump 3 1/2 hp - 17
(HP) (yield gpm)

Electric
(type power)

(7) electric log NO
(yes or no)

_____ (organization running log)

CODED

(8) how well bottom plugged wooden plug


DRILLERS REMARKS:

DEC 31 1969

MISS. BD. OF
WATER COMM.

If well telescopes please sketch and show depths.

GROUND LEVEL

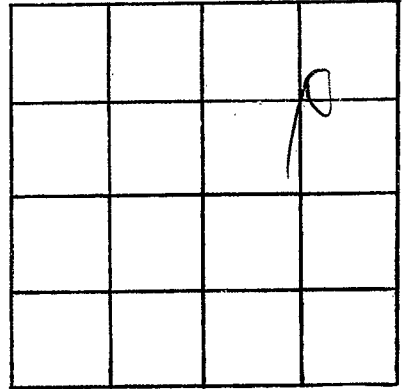

SECTION 78

Please indicate well location X.

ADDITIONAL INFORMATION

If more than one screen, show locations of each on sketch.