

Pike
H84
11-15-69

MISSISSIPPI
BOARD OF WATER COMMISSIONERS
416 North State Street
Jackson, Mississippi 39201

CODED

WATER WELL DRILLERS LOG

Nov 15 69 Reverwell Drilling Co. Pike
date well completed firm name county well located

LANDOWNER: M. J. Canedy
RT-1, Magnolia

description of formations encountered	from	to
<u>Red clay</u>	<u>0</u>	<u>16</u>
<u>Red chert clay</u>		
<u>Red chert & sand</u>	<u>16</u>	<u>72</u>
<u>Red chert with sand & gravel</u>	<u>72</u>	<u>98</u>
<u>Red chert</u>	<u>98</u>	<u>107</u>
<u>Small gravel & sand</u>	<u>107</u>	<u>117</u>

(mailing address)

WELL LOCATION:
sec. 16 T 2 N R. 9 E
4 1/2 miles E of Magnolia
(distance) (direction) (nearest town)

WELL PURPOSE: drain
(home, irrigation, municipal, industrial)

- WELL COMPLETION DATA:
- (1) diameter (inches) 4"
 - (2) total depth (feet) 117
 - (3) static water level (feet) 83 below top of ground.
 - (4) casing Plastic, Galvan
(material) (depth)
 - (5) screen 6' 111
(length) (depth to top)
4 1/2" Plastic
(size) (material)
 - (6) pump 1 HP Jet-B
(HP) (yield gpm)
Electric
(type power)
 - (7) electric log No
(yes or no)
 - (8) how well bottom plugged wooden plug

CODED


DRILLERS REMARKS:

DEC 31 1969

MISS. Bd. of WATER COMMISSIONERS

If well telescopes please sketch and show depths.

GROUND LEVEL

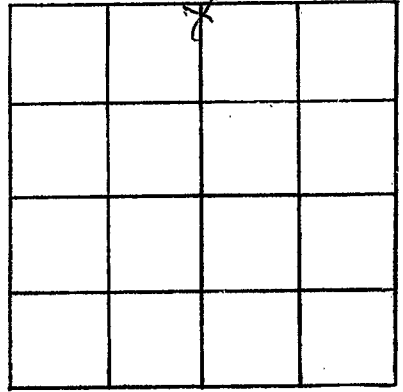

SECTION 16

Please indicate well location X.

ADDITIONAL INFORMATION

If more than one screen,
show locations of each on sketch.