

Oke
H 86
12-27-69

MISSISSIPPI
 BOARD OF WATER COMMISSIONERS
 416 North State Street
 Jackson, Mississippi 39201

CODED

WATER WELL DRILLERS LOG

27 Dec 1969 date well completed J. J. Armstrong firm name Pike county well located

LANDOWNER: Bub Magall
Bub Magall's
 (mailing address)

WELL LOCATION:
 sec. 11 T. 2 N. R. 8 E. SW
3 miles W of Magnolia
 (distance) (direction) (nearest town)

WELL PURPOSE:
 (home, irrigation, municipal, industrial)

WELL COMPLETION DATA:
 (1) diameter (inches) 4
 (2) total depth (feet) 126
 (3) static water level (feet) 35 below above top of ground.
 (4) casing Plc 120
 (material) (depth)
 _____ if telescope see back.
 (size)
 (5) screen 6 120
 (length) (depth to top)
4 Plc
 (size) (material)
 (6) pump 1/2 10
 (HP) (yield gpm)
Elva
 (type power)
 (7) electric log _____
 (yes or no)

 (organization running log)
 (8) how well bottom plugged wood

description of formations encountered	from	to
<u>clay</u>	<u>0</u>	<u>10</u>
<u>clay</u>	<u>10</u>	<u>25</u>
<u>clay & sand</u>	<u>25</u>	<u>50</u>
<u>red brick clay</u>	<u>50</u>	<u>80</u>
<u>red shale</u>	<u>80</u>	<u>90</u>
<u>sand</u>	<u>90</u>	<u>126</u>

CODED


JAN - 5 1970

MISS. ED. OF
 WATER COMM.

DRILLERS REMARKS:

If well telescopes please sketch and show depths.

GROUND LEVEL

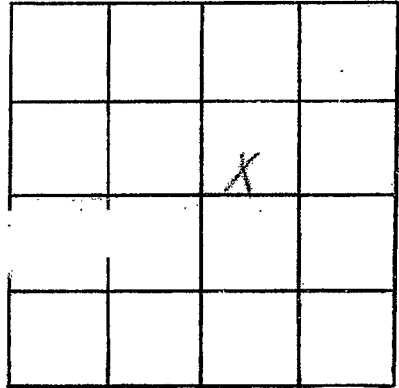

SECTION 11

Please indicate well location X.

ADDITIONAL INFORMATION

If more than one screen, show locations of each on sketch.