

PIKE
H 88
11-11-69

MISSISSIPPI
BOARD OF WATER COMMISSIONERS
416 North State Street
Jackson, Mississippi 39201

CODED

WATER WELL DRILLERS LOG

11-11-1969 date well completed Fitzgerald well drill firm name Pike county well located

LANDOWNER:
M. D. Hayles
B.R. Maguire, Jr.
(mailing address)
WELL LOCATION:
sec. 6 T 2 S R 8 NE 1/4 NW 1/4
1 miles S of Farmers
(distance) (direction) (nearest town)

description of formations encountered	from	to
<u>Red clay</u>	<u>0</u>	<u>20</u>
<u>Red sand</u>	<u>20</u>	<u>80</u>
<u>white clay</u>	<u>80</u>	<u>140</u>
<u>loose soil</u>	<u>140</u>	<u>170</u>
<u>Coarse sand & gravel</u>	<u>170</u>	<u>183</u>

WELL PURPOSE: sawmill
(home, irrigation, municipal, industrial)

WELL COMPLETION DATA:
(1) diameter (inches) 4
(2) total depth (feet) 183
(3) static water level (feet) 30 below top of ground.
(4) casing plastic, 175 (material) (depth)
4 (size) if telescope see back.
(5) screen 8, 175 (length) (depth to top)
4 (size), plastic (material)
(6) pump 3/4, 16 (HP) (yield gpm)
elec (type power)
(7) electric log yes (yes or no)
(organization running log)
(8) how well bottom plugged wood plug

CODED


NOV 21 1969

DRILLERS REMARKS:

MISSISSIPPI
BOARD OF WATER COMMISSIONERS

If well telescopes please sketch and show depths.

GROUND LEVEL

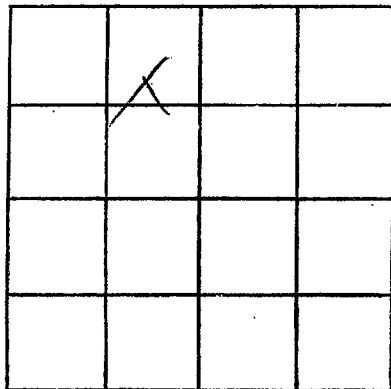

SECTION 6

Please indicate well location X.

ADDITIONAL INFORMATION

If more than one screen,
show locations of each on sketch.